20850

IREDELL COUNTY HEALTH DEPARTMENT

STATESVILLE 704-878-5305 MOORESVILLE 704-664-5281 WS III

IMPROVEMENT PERMIT / CERTIFICATE OF COMPLETION / OPERATION PERMIT / EXISTING SYSTEM INSPECTION

PROPERTY DESCRIPTION NO 20850 DATE 4/19/95 TAX MAP NO 12K-A-34 Watershed: ☐ Yes

OWNER OR CONTRACTOR LOUISE JAMES PHONE: Business Home 546-2164

ADDRESS 137 PINEY GROVE RD, HARMONY, NC 28634

LOCATION US 21 N, TR NO 101 TL GUILFORD, TL FOX HUNTER, TL PINEY GROVE, ~0.3 MI ON L

SUBDIVISION ADA GRAY ESTATES BLOCK SECTION LOT 1 LOT AREA 5.747 AC SITE CLASS P3 DESIGN FLOW 240 LTAR 0.3 GPD/FT

Septic Tank 1000 Gallons Date 2/3/95

Pump Tank Gallons P1 Date

Pump Make Model Serial No

Manifold Valve Reqd: 1 Square Feet 810 Linear Feet 270

No Lines 3 Trench Width 36 Max Trench Bottom Depth 18-24 Gravel Depth 12

New System Repair System Type CONV, GRAVITY

System Description: CONV, GRAVITY

Repair System Description: CONV, GRAVITY

Maintenance Agreement Required: ☐ Yes ☐ No

☐ House/Mod. Home No. Bedrooms 3

☐ Mobile Home No. Bathrooms 2

☐ Business No. Employees

☐ Other


☐ Slab ☐ Crawl Space ☐ Basement w/plumbing ☐ Basement w/o/plumbing

Water Supply: ☐ Individual ☐ Community ☐ Public


Comments: ① INITIAL LINES NO DEEPER THAN 24" AS SHOWN ON SKETCH ② SYSTEM INSTALLED TO ACCOMODATE 2 BR ONLY

Comments: SYSTEM NOT INSTALLED IN ACCORDANCE WITH ORIGINAL IMPROVEMENT PERMIT. NINETY FEET OF DRAINLINE ADDED TO COMPENSATE FOR SYSTEM INSTALLED OUT OF CONTOUR. SETBACKS CHANGED PER KATRINA HEWITT, PLANNING DEPT.

INITIAL SITE SKETCH

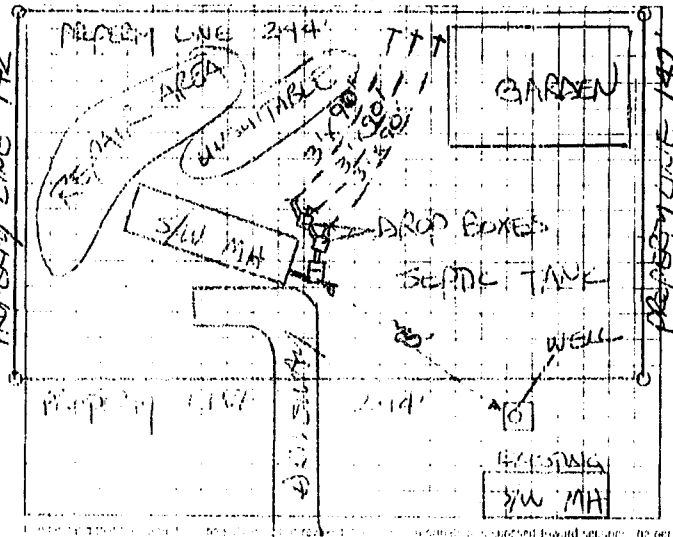

AS BUILT SKETCH

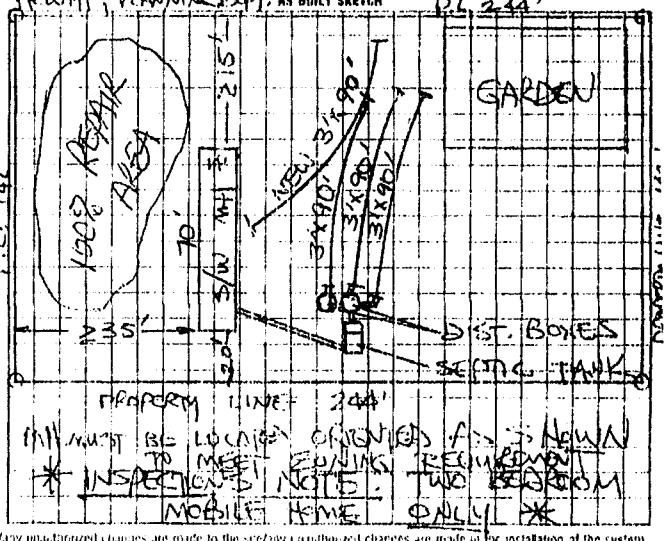

* INSPECTIONS NOTE: TWO BEDROOM MOBILE HOME ONLY *

All work shall be located, oriented & sized as shown to meet existing requirements

Signature [illegible] Date 1/19/95

Installed by A.J. Goodbee

Certificate of Completion by

Operation Permit by STEVE HEDRICK date 7-10-96

WHITE COPY (OFFICE) YELLOW (INSPECTOR'S COPY) PINK (OWNER COPY) GOLD

JAN. 1, 1989 17:47