IREDELL COUNTY HEALTH DEPARTMENT

STATESVILLE 704-878-5305 MOORESVILLE 704-664-5281

IMPROVEMENT PERMIT / CERTIFICATE OF COMPLETION / OPERATION PERMIT / EXISTING SYSTEM INSPECTION

PROPERTY DESCRIPTION NO. REPAIR DATE 4/4/94 TAX MAP NO. Watershed: ☐ Yes ☐ No

OWNER OR CONTRACTOR LOUISE JAMES PHONE: Business Home 546-2164

ADDRESS RT 1 BOX 272 HARMONY NC 28634

LOCATION US 21 N, TR NC 901, TL GUILFORD, TL FOX HUNTER DS TR PINEY GROVE, 2ND MH ON (L)

SUBDIVISION BLOCK / SECTION LOT LOT AREA SITE CLASS. 1 DS DESIGN FLOW 480 L.T.A.R. EXISTING

Septic Tank: EXISTING Gallons; STB Date

Pump Tank: Gallons; PT Date

Pump Make: Model Serial No.

Nitrification Field: No Fields 1 Square Feet 1005 Linear Feet 135

No Lines 1 Trench Width 36" Max Trench Bottom Depth 18-36" Gravel Depth 18"

☐ New System ☑ Repair System Type: I (II) III, IV, V, VI

System Description:

Repair System Description: CONV. GRAVITY

Maintenance Agreement Required: ☐ Yes ☑ No

☐ House/Mod. Home ☑ Mobile Home ☐ Business ☐ Other

No. Bedrooms 4 No. Bathrooms 2 No. Employees


☐ Slab ☑ Crawl Space ☐ Basement w/plumbing ☐ Basement wo/plumbing

Water Supply: ☑ Individual ☐ Community ☐ Public WELL

Comments: (1) INSTALL NEW 3' X 135' LINE ON CONTOUR USING 18" STONE (2) KEEP 50' FROM WELL (3) CUT OFF OLD DRAINLINE 5' FROM PROPERTY LINE & DAM OFF. (4) REPAIR BY 5/4/94

Comments:

INITIAL SITE SKETCH

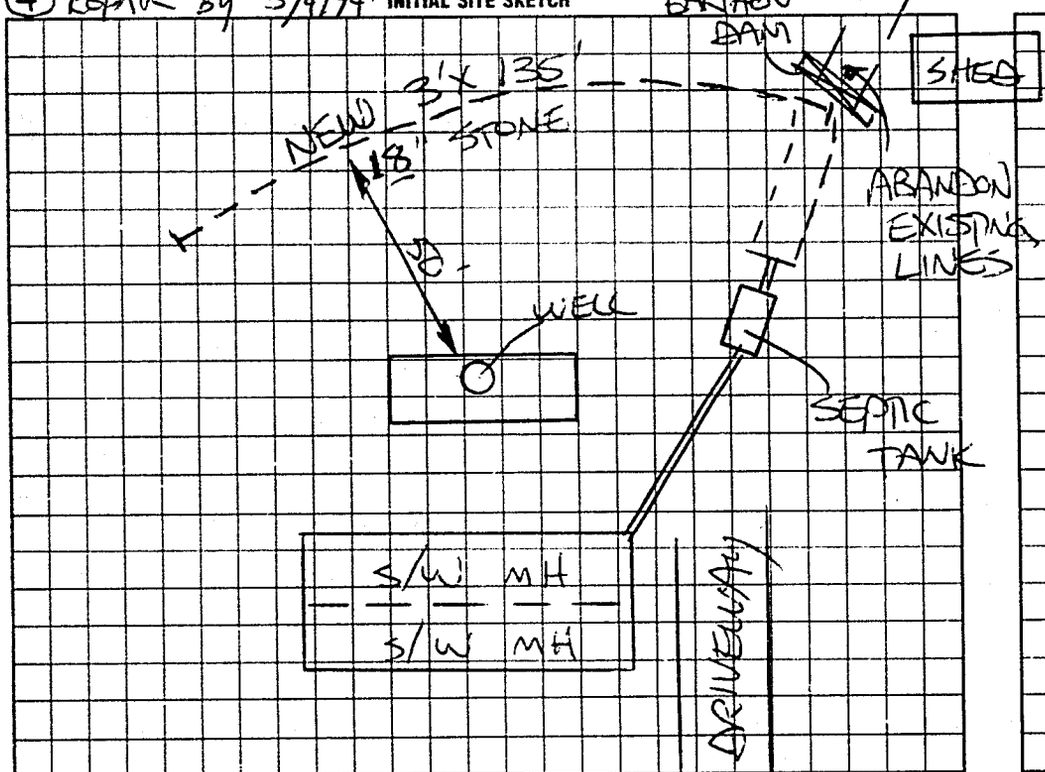

AS BUILT SKETCH

SYSTEM REPAIRED ACCORDING TO INITIAL SITE SKETCH

I understand that this permit can be suspended or revoked if any false information is supplied toward securing the permit/any unauthorized changes are made to the site/any unauthorized changes are made in the installation of the system. Improvement Permit is valid for 60 months from date of issuance.

Signed: X Louise James

Improvement Permit by: STEVE HEDRICK date 4/4/94

Existing System Inspection by: X date

Installed by: J.C's BACKHOE SERVICE

Certificate of Completion by: STEVE HEDRICK date 4/19/94

Operation Permit by: date

HEALTH DEPT. COPY. WHITE INSPECTION COPY (FINAL) GREEN OWNER COPY (FINAL) YELLOW INSPECTION COPY (INITIAL) PINK OWNER COPY (INITIAL). GOLD

21300