Bobby Anderson

204627

# IREDELL COUNTY HEALTH DEPARTMENT

STATESVILLE 704-878-5305 MOORESVILLE 704-664-5281

## IMPROVEMENT PERMIT / AUTHORIZATION TO CONSTRUCT / OPERATION PERMIT / EXISTING SYSTEM INSPECTION

PERMIT# 074761 PIN# 4890 59 7707 DATE 7-17-98

OWNER OR CONTRACTOR RANDALL KELLER PHONE: Business (336) 751-2153 Home 546-5127

ADDRESS 896 SHEFFIELD ROAD, HARMONY, NC 28634

LOCATION US 21 N, TR NO 901 E, TL SHEFFIELD RD, 1 ON RIGHT JUST BEFORE COUNTY LINE

SUBDIVISION _____ BLOCK / SECTION _____ LOT _____ LOT AREA 4.28 ACRES SITE CLASS. PS DESIGN FLOW 360 L.T.A.R. 0.30 GPD/FT²

Septic Tank: 1000 Gallons; STB 760 Date 10-6-98
Pump Tank: _____ Gallons; PT _____ Date _____
Pump Make: _____ Model _____ Serial No. _____
Nitrification Field: No Fields 1 Square Feet EQ. TO 1200 Linear Feet 300+
No Lines THREE Trench Width 36" Max Trench Bottom Depth 36"

☑ New System ☐ Repair System Type: I, II, III, IV, V, VI
System Description: 25% REDUCTION - GRAVITY
Repair System Description: 25% REDUCTION - PUMP
Maintenance Agreement Required: ☐ Yes ☑ No

☑ House/Mod. Home No. Bedrooms 3
☐ Mobile Home No. Bathrooms 3
☐ Business No. Employees ____
☐ Other _____


Water Supply: ☐ Individual ☐ Public ☐ Community

~~Gravel~~ Depth SAND 6" ☐ Slab ☐ Crawl Space ☑ Basement w/plumbing ☐ Basement wo/plumbing

Comments/Conditions: INSTALL 25% REDUCTION SYSTEM AS FLAGGED ON SITE (50 CHAMBERS OR 30 HDS SECTION LENTHS).

Comments/Conditions: MH TO BE REMOVED UPON OCCUPANCY OF HOUSE.

INITIAL SITE SKETCH SCALE: 1"=50'

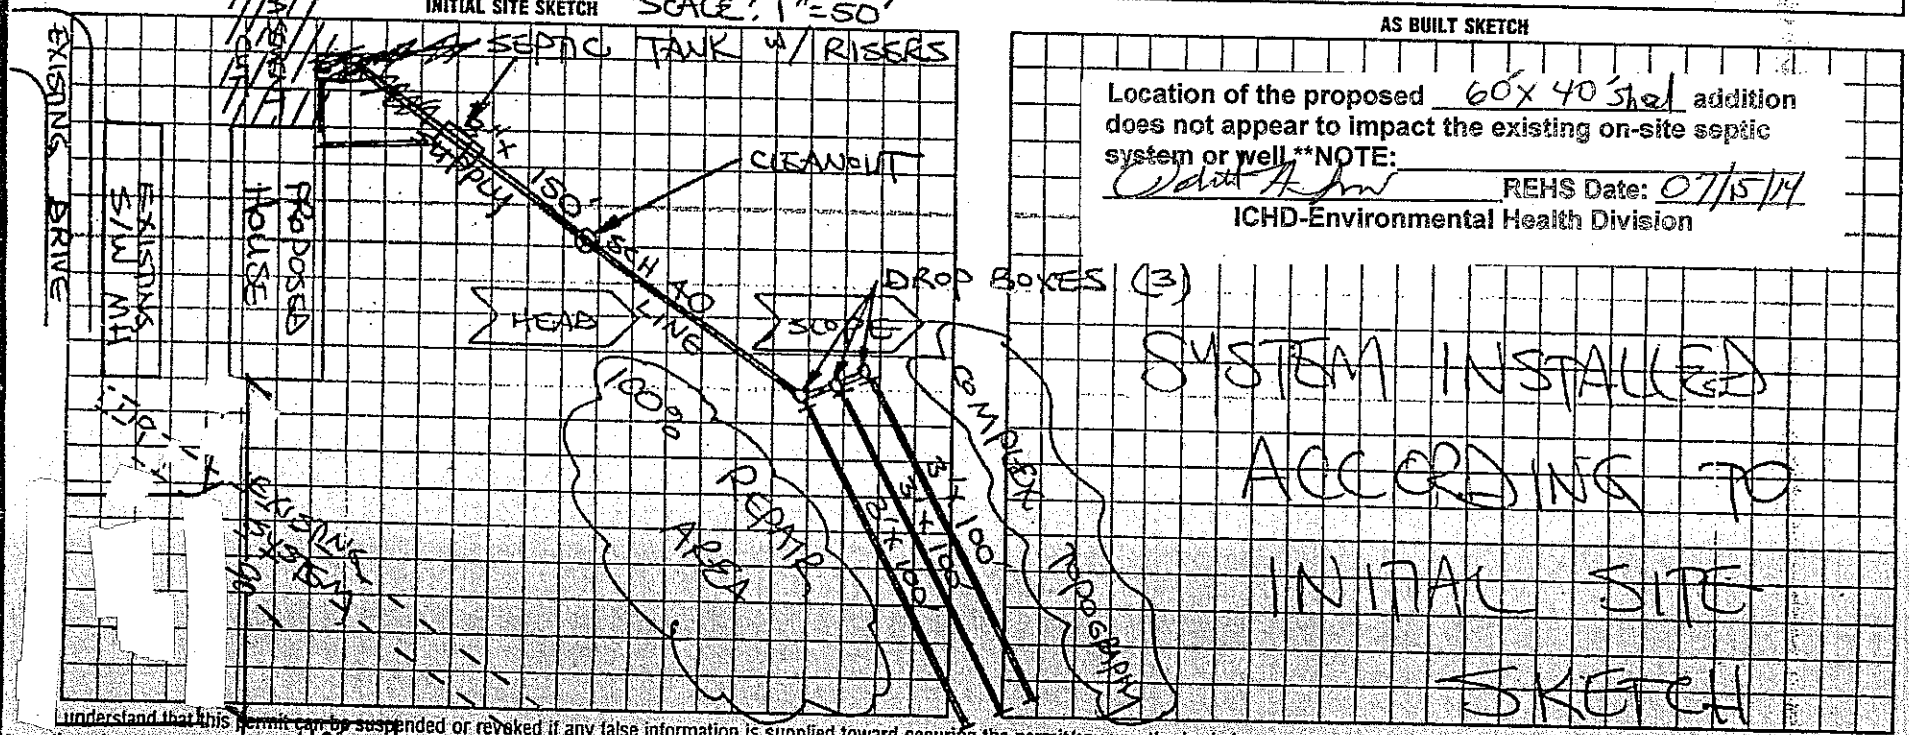


AS BUILT SKETCH

Location of the proposed 60'x 40' Shed addition does not appear to impact the existing on-site septic system or well.**NOTE:

REHS Date: 07/15/14

ICHD-Environmental Health Division

SYSTEM INSTALLED ACCORDING TO INITIAL SITE SKETCH

I understand that this permit can be suspended or revoked if any false information is supplied toward securing the permit/any unauthorized changes are made to the site/any unauthorized changes are made in the installation of the system. Improvement Permit with plat valid without expiration. Improvement Permit with site plan valid for sixty months. Authorization to Construct is valid for a period equal to that of Improvement Permit – not to exceed sixty months.

Signed: [signature] date 7-22-98 Installed by: DONALD LAKEY

Improvement Permit by: STEVE HEDRICK date 7-17-98 Operation Permit by: STEVE HEDRICK date 12-28-98

Authorization to Construct by: STEVE HEDRICK date 7-17-98 Existing System Inspection by: _____ date _____

HEALTH DEPT. COPY: WHITE INSPECTION COPY (FINAL): GREEN OWNER COPY (FINAL): YELLOW INSPECTION COPY (INITIAL): PINK OWNER COPY (INITIAL): GOLD