IREDELL COUNTY HEALTH DEPARTMENT

STATESVILLE 704-878-5305 MOORESVILLE 704-664-5281

IMPROVEMENT PERMIT / CERTIFICATE OF COMPLETION / OPERATION PERMIT / EXISTING SYSTEM INSPECTION

PROPERTY DESCRIPTION NO. 17837 DATE 1/12/95 TAX MAP NO. 17A-A-20 Watershed: ☐ Yes ☒ No

OWNER OR CONTRACTOR RANDALL S. KELLER PHONE: Business Home 546-7253

ADDRESS RT-1 BOX 399, HARMONY, NC 28634

LOCATION US21 N, TR NC 901, TL STEFFIELD ROAD ~ 1 MILE ON (R) PAST GREASE PLANT

SUBDIVISION BLOCK / SECTION LOT LOT AREA 4.28 AC SITE CLASS. PS DESIGN FLOW 240 L.T.A.R. 0.33 GPD/FT²

Septic Tank: 1000 Gallons; STB 760 Date 11/28

Pump Tank: Gallons; PT Date

Pump Make: Model Serial No.

Nitrification Field: No Fields 1 Square Feet 720 Linear Feet 240

No Lines 2 Trench Width 36" Max Trench Bottom Depth 18-36" Gravel Depth 12"

☒ New System ☐ Repair System Type: I, (II), III, IV, V, VI

System Description: CONVENTIONAL GRAVITY

Repair System Description: CONV. GRAVITY

Maintenance Agreement Required: ☐ Yes ☒ No

☐ House/Mod. Home ☒ Mobile Home ☐ Business ☐ Other

No. Bedrooms 2 No. Bathrooms 1 No. Employees


☐ Slab ☒ Crawl Space ☐ Basement w/plumbing ☐ Basement wo/plumbing

Water Supply: ☒ Individual ☐ Community ☐ Public WELL

Comments: (1) KEEP WELL 100' FROM SYSTEM (2) INSTALL LINES AS SHOWN, NO DEEPER THAN 36" 9' APART MINIMUM ON CENTER, ON CONTOUR

Comments:

INITIAL SITE SKETCH

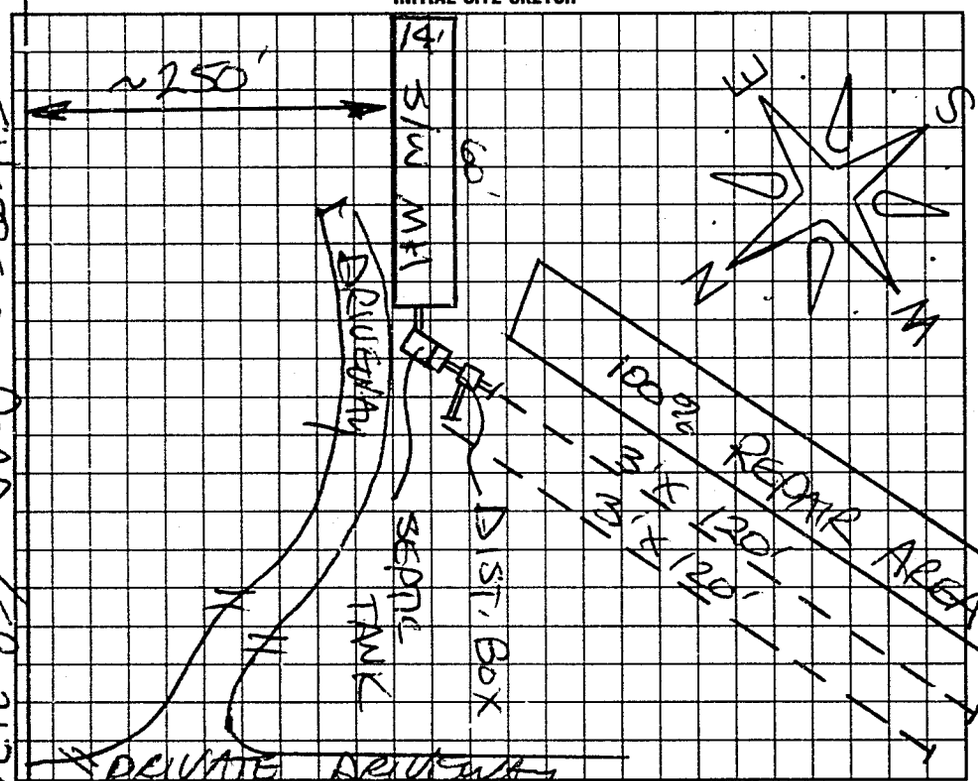

AS BUILT SKETCH

SYSTEM INSTALLED ACCORDING TO INITAL SITE SKETCH

I understand that this permit can be suspended or revoked if any false information is supplied toward securing the permit/any unauthorized changes are made to the site/any unauthorized changes are made in the installation of the system. Improvement Permit is valid for 60 months from date of issuance.

Signed: Randy Keller

Improvement Permit by: STEVE HEDRICK date 1/12/95

Existing System Inspection by: date

Installed by: RICHARD FOSTER

Certificate of Completion by: STEVE HEDRICK date 1/26/95

Operation Permit by: date

HEALTH DEPT. COPY: WHITE INSPECTION COPY (FINAL): GREEN OWNER COPY (FINAL): YELLOW INSPECTION COPY (INITIAL): PINK OWNER COPY (INITIAL): GOLD