IREDELL COUNTY HEALTH DEPARTMENT

STATESVILLE 704-878-5305 MOORESVILLE 704-664-5281

IMPROVEMENT PERMIT / AUTHORIZATION TO CONSTRUCT / OPERATION PERMIT / EXISTING SYSTEM INSPECTION

PERMIT# REPAIR PIN# 4729-16-1873 DATE 8-17-04

OWNER OR CONTRACTOR CLAUDE WOOTEN PHONE: Business Home (704) 546-2652

ADDRESS 916 SHEFFIELD RD. HARMONY 28634

LOCATION I-77N TR HWY 901 TL SHEFFIELD / MILE PAST PROCESSING PLANT ON RIGHT

SUBDIVISION BLOCK / SECTION LOT LOT AREA SITE CLASS. PS DESIGN FLOW 360 L.T.A.R. EXISTING

Septic Tank: 1000 Gallons; STB 620 Date 7-20-04
Pump Tank: Gallons; PT Date
Pump Make: Model Serial No.
Nitrification Field: No Fields 1 Square Feet Linear Feet 350
No Lines 4 Trench Width 36" Max Trench Bottom Depth 36" Gravel Depth 14"

☐ New System ☑ Repair System Type: I, II, III, IV, V, VI
System Description:
Repair System Description: CONVENTIONAL GRAVITY
Maintenance Agreement Required: ☐ Yes ☑ No

☑ House/Mod. Home No. Bedrooms 3
☐ Mobile Home No. Bathrooms
☐ Business No. Employees
☐ Other
☐ Slab ☐ Crawl Space ☑ Basement w/plumbing ☐ Basement wo/plumbing

Water Supply: ☑ Individual ☑ Public ☐ Community


Comments/Conditions: ① ABANDON EXISTING SYSTEM / PUMP, CRUSH, AND FILL OLD SEPTIC TANK ② INSTALL NEW LINES ON CONTOUR ③ MAINTAIN SETBACK (50') FROM WELL ④ THIS SERVES AS A 30-DAY NOV TO HAVE SYSTEM

Comments/Conditions: ① ZABEL ② #5


* SYSTEM INSTALLED ACCORDING TO SKETCH

* SHEFFIELD ROAD

SCALE 1" = 50' INITIAL SITE SKETCH REPAIRED / ABANDONED

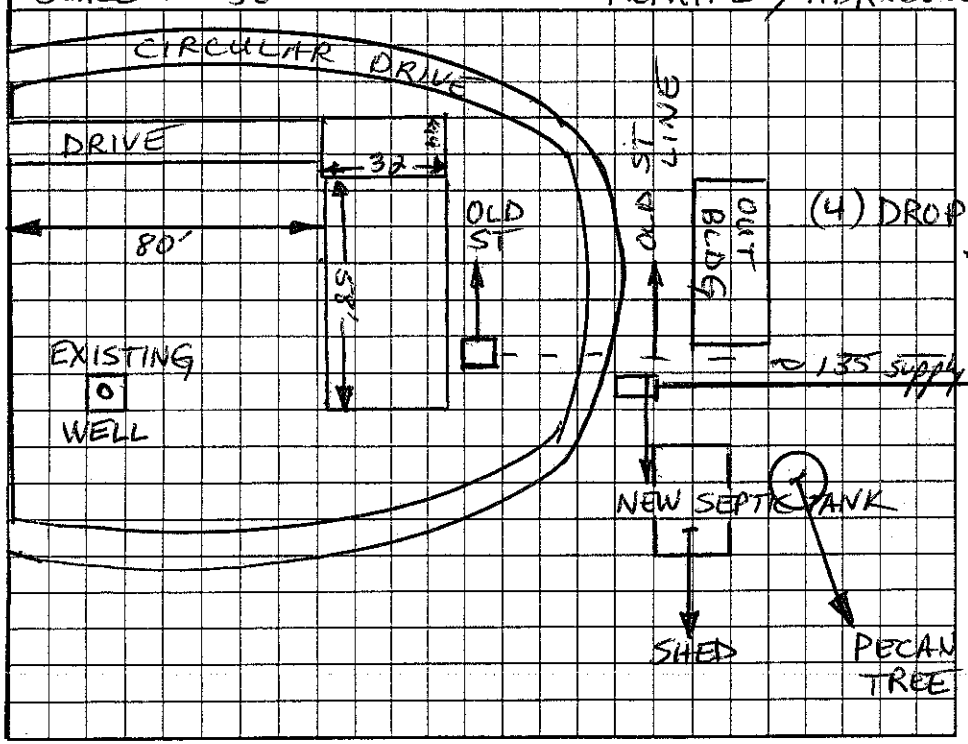

AS BUILT SKETCH

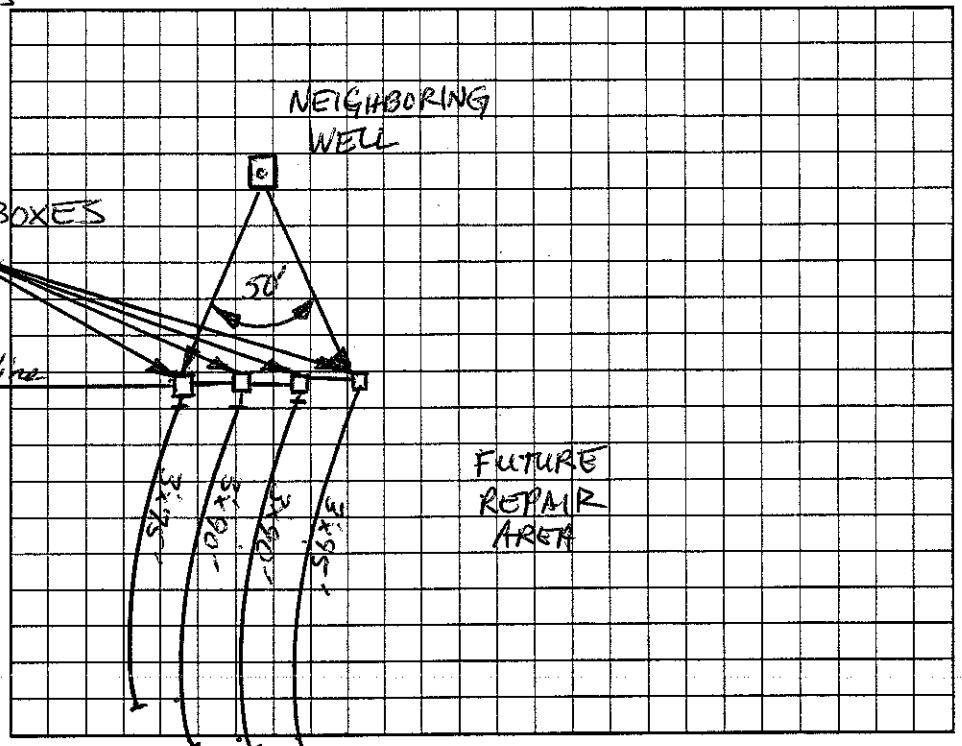

Permit can be suspended or revoked if any false information is supplied toward securing the permit/any unauthorized changes are made to the site/any unauthorized changes are made in the installation of the system. Improvement Permit with plat valid without expiration. Improvement Permit with site plan valid for sixty months. Authorization to Construct is valid for a period equal to that of Improvement Permit – not to exceed sixty months.

Signed: Claude Wooten date

Improvement Permit by: Christopher M. Shirley, RS date 8-17-04

Authorization to Construct by: Christopher M. Shirley, RS date 8-17-04

Installed by: NIXON'S BACKHOE

Operation Permit by: Christopher M. Shirley, RS date 8-23-04

Existing System Inspection by: date

HEALTH DEPT. COPY: WHITE OWNER COPY (FINAL): YELLOW OWNER COPY (INITIAL): PINK