IREDELL COUNTY HEALTH DEPARTMENT - *ENVIRONMENTAL HEALTH* ☒ STATESVILLE OFFICE 704-878-5305 ☐ MOORESVILLE OFFICE 704-664-5281

IMPROVEMENT PERMIT / AUTHORIZATION TO CONSTRUCT / OPERATION PERMIT / EXISTING SYSTEM INSPECTION

PERMIT # Repair PIN # 4890-69-8672 DATE 1-31-12

OWNER Angela Gillespie APPLICANT: PHONE: Home/Cell # 704-546-2852 Business #

SITE ADDRESS 2258 Sheffield Rd OWNER / APPLICANT ADDRESS

SITE DIRECTIONS 21N, (R) on 901, (L) on Sheffield, property on (L) @ Iredell/Davie line.

SUBDIVISION n/a BLOCK / SECTION n/a LOT # n/a LOT AREA .98 Ac DESIGN FLOW 240 L.T.A.R. .25

Septic Tank 1000 (if nec.) Gallons: STB Date
Pump Tank Gallons: P T Date
Pump Make Model Serial #
No. Nitrification Fields: 1 No. Lines Linear Feet 240
Trench Width 36" Max. Trench Bottom Depth 36" Gravel Depth n/a

☐ New System ☒ Repair ☐ Expansion System Type I II III IV V VI
System Description:
Repair System Description: 25% Reduction Gravity
Maintenance Agreement Required ☐ YES ☒ NO
☒ GRAVITY ☐ PRESSURE


☒ Residence No. Bedrooms 2
☐ Business No. Persons
☐ Other No. Employees
☐ Slab ☒ Crawl Space
☐ Basement w/plumbing ☐ Basement w/o plumbing

Water Supply: ☒ Private ☐ Public ☐ Community

Comments / Conditions

Tank may be replaced if necessary (if not, add a "T" to the outlet end of tank

INITIAL SITE SKETCH

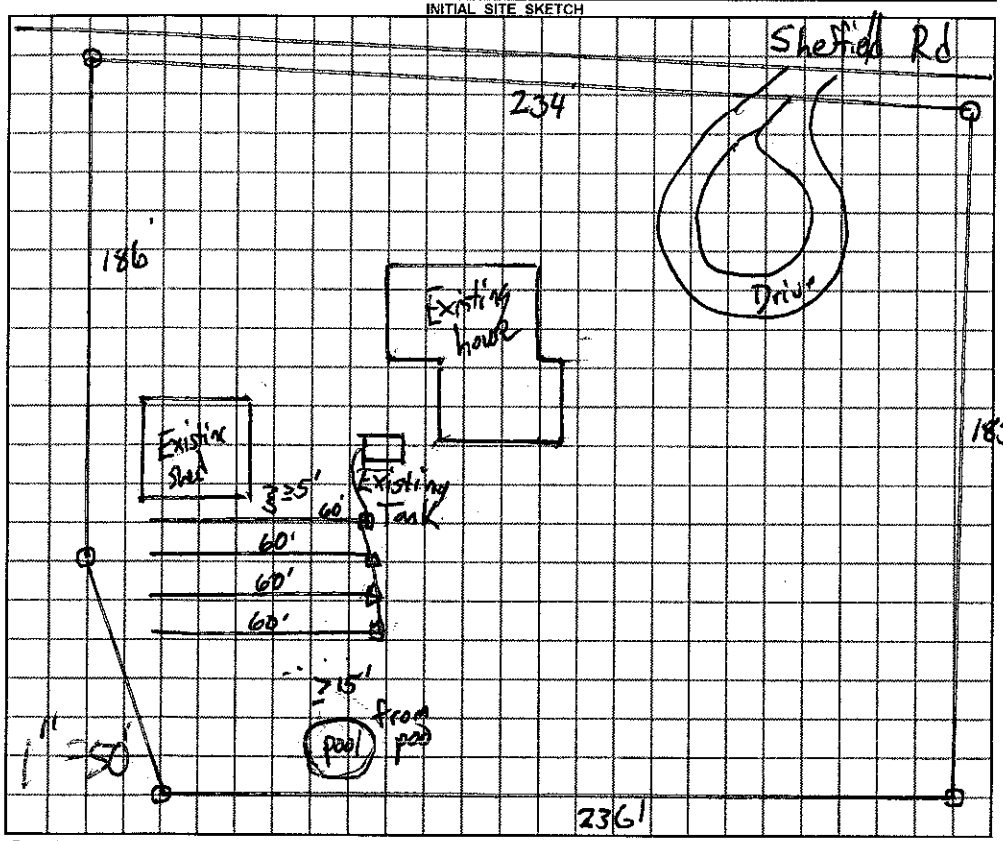

AS BUILT SKETCH

Permit can be suspended or revoked if any false information is supplied toward securing the permit / any unauthorized changes are made to the site / any unauthorized changes are made in the installation of the system.

☐ ***IMPROVEMENT PERMIT*** with plat valid without expiration ☒ ***IMPROVEMENT PERMIT*** with plat valid without expiration. site plan valid 60 mo. ☒ ***AUTHORIZATION TO CONSTRUCT*** valid for period equal to IMPROVEMENT PERMIT–not to exceed 60 mo.

Owner / Applicant Signature: Angela Gillespie Date 2-1-12 Installed by: Sherman Dunn Grading

IMPROVEMENT PERMIT by: REHS Date 1-31-12 OPERATION PERMIT by: REHS Date 2-9-12

AUTHORIZATION TO CONSTRUCT by: REHS Date 1-31-12 Existing System Inspected by: REHS Date

YOU SHOULD CONTACT A LOCATOR SERVICE PRIOR TO ANY EXCAVATION

White Copy – Environmental Health YELLOW COPY (Final) Owner / Applicant PINK COPY (Initial) Owner / Applicant