IREDELL COUNTY HEALTH DEPARTMENT

STATESVILLE 704-878-5305 MOORESVILLE 704-664-5281

IMPROVEMENT PERMIT / AUTHORIZATION TO CONSTRUCT / OPERATION PERMIT / EXISTING SYSTEM INSPECTION

PERMIT# REPAIR PIN# 4891-02-7469 11-0837 DATE 2-26-04

OWNER OR CONTRACTOR LINDA SNOW STROUD PHONE: Business Home 704-546-7486

ADDRESS 178 RAVEN ROAD, HARMONY, NC 28634-9778

LOCATION US 21 NORTH, TR NC 901, TL SHEFFIELD RD, TL RAVEN RD, 0.3 MILE ON RIGHT AT #178

SUBDIVISION _____ BLOCK / SECTION _____ LOT _____ LOT AREA 37.84 ACRES SITE CLASS. PS DESIGN FLOW 360 L.T.A.R. 0.30 GPD/FT2

Septic Tank: EXISTING Gallons; STB _____ Date _____

Pump Tank: _____ Gallons; PT _____ Date _____

Pump Make: _____ Model _____ Serial No. _____

Nitrification Field: No Fields 1 Square Feet 780 Linear Feet 260

No Lines _____ Trench Width 36" Max Trench Bottom Depth 36"

☑ New System ☐ Repair System Type: I, II, III, IV, V, VI

System Description: _____

Repair System Description: CONVENTIONAL GRAVITY

Maintenance Agreement Required: ☐ Yes ☑ No

Gravel Depth 18"

☑ House/Mod. Home No. Bedrooms 3

☐ Mobile Home No. Bathrooms 1

☐ Business No. Employees ____

☐ Other _____

☐ Slab ☑ Crawl Space ☐ Basement w/plumbing ☐ Basement wo/plumbing


Water Supply: ☑ Individual ☐ Public ☐ Community

WELL

Comments:/Conditions: ① CHECK INTEGRITY OF EXISTING SEPTIC TANK, REPLACE IF NECESSARY ② INSTALL NEW LINES ON CONTOUR AS FLAGGED USING 18" STONE

Comments:/Conditions: NEW SANITARY TEE INSTALLED IN SEPTIC TANK

INITIAL SITE SKETCH

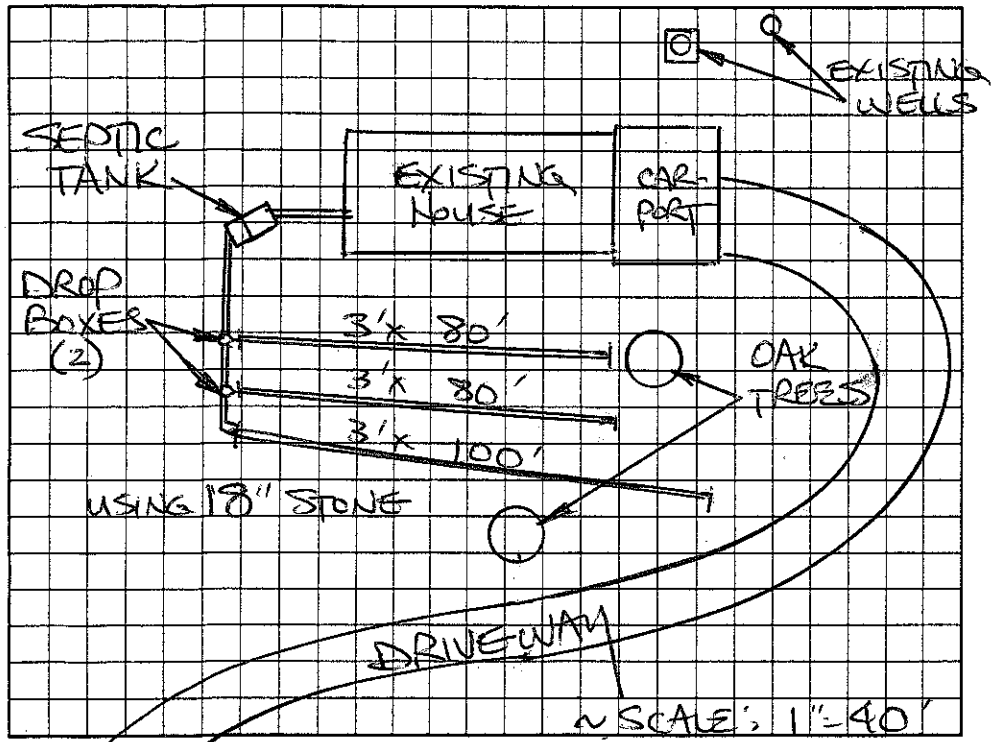

AS BUILT SKETCH

SYSTEM REPAIRED ACCORDING TO INITIAL SITE SKETCH

Permit can be suspended or revoked if any false information is supplied toward securing the permit/any unauthorized changes are made to the site/any unauthorized changes are made in the installation of the system. Improvement Permit with plat valid without expiration. Improvement Permit with site plan valid for sixty months. Authorization to Construct is valid for a period equal to that of Improvement Permit – not to exceed sixty months.

Signed: Linda Stroud date 2-26-04

Improvement Permit by: STEVE HEDRICK date 2-26-04

Authorization to Construct by: STEVE HEDRICK date 2-26-04

Installed by: A-1 BACKHOE

Operation Permit by: STEVE HEDRICK date 3-19-04

Existing System Inspection by: _____ date _____

HEALTH DEPT. COPY: WHITE OWNER COPY (FINAL): YELLOW OWNER COPY (INITIAL): PINK