IREDELL COUNTY HEALTH DEPARTMENT

STATESVILLE 704-878-5305 MOORESVILLE 704-664-5281

IMPROVEMENT PERMIT / AUTHORIZATION TO CONSTRUCT / OPERATION PERMIT / EXISTING SYSTEM INSPECTION

PERMIT# REPAIR PIN# 4891-11-6546 DATE 3-21-03

OWNER OR CONTRACTOR BARBARA TRENT PHONE: Business Home 704-546-2519

ADDRESS 148 RAVEN ROAD, HARMONY, NC 28634

LOCATION US 21 NORTH, TR NC 901, TL SHEFFIELD RD, TL RAVEN ROAD, DRIVE ON RIGHT AT BOX # 148

SUBDIVISION BLOCK / SECTION LOT LOT AREA 1.9 ACRES SITE CLASS. PS DESIGN FLOW 360 L.T.A.R. EXISTING

Septic Tank: EXISTING Gallons; STB Date

Pump Tank: Gallons; PT Date

Pump Make: Model Serial No.

Nitrification Field: No Fields 1 Square Feet 720 Linear Feet 240

No Lines THREE Trench Width 36" Max Trench Bottom Depth 36" Gravel Depth 12"

☐ New System ☑ Repair System Type: I, (II), III, IV, V, VI

System Description:

Repair System Description: CONVENTIONAL, GRAVITY

Maintenance Agreement Required: ☐ Yes ☒ No

☐ House/Mod. Home ☑ Mobile Home ☐ Business ☐ Other

No. Bedrooms 3 No. Bathrooms 2 No. Employees


☐ Slab ☑ Crawl Space ☐ Basement w/plumbing ☐ Basement wo/plumbing

Water Supply: ☑ Individual ☐ Public ☐ Community WELL


Comments/Conditions: (1) DISCONNECT EXISTING SINGLE-WIDE MOBILE HOME FROM SYSTEM (2) INTERCEPT EXISTING DRAINLINE AT LOCATION SHOWN (3) INSTALL DROP BOXES AT END AS SHOWN TO ACHIEVE SERIAL DISTRIBUTION.

Comments/Conditions: (4) THIS PERMIT SERVES AS "NOTICE OF VIOLATION," SYSTEM TO BE REPAIRED BY 4-21-03

INITIAL SITE SKETCH

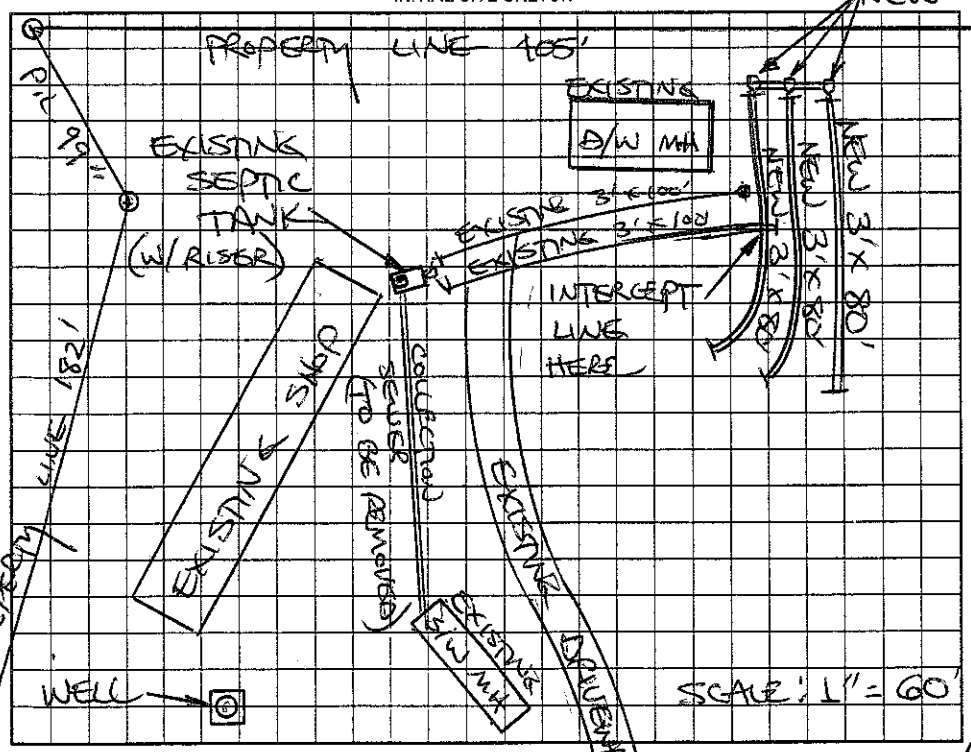

AS BUILT SKETCH

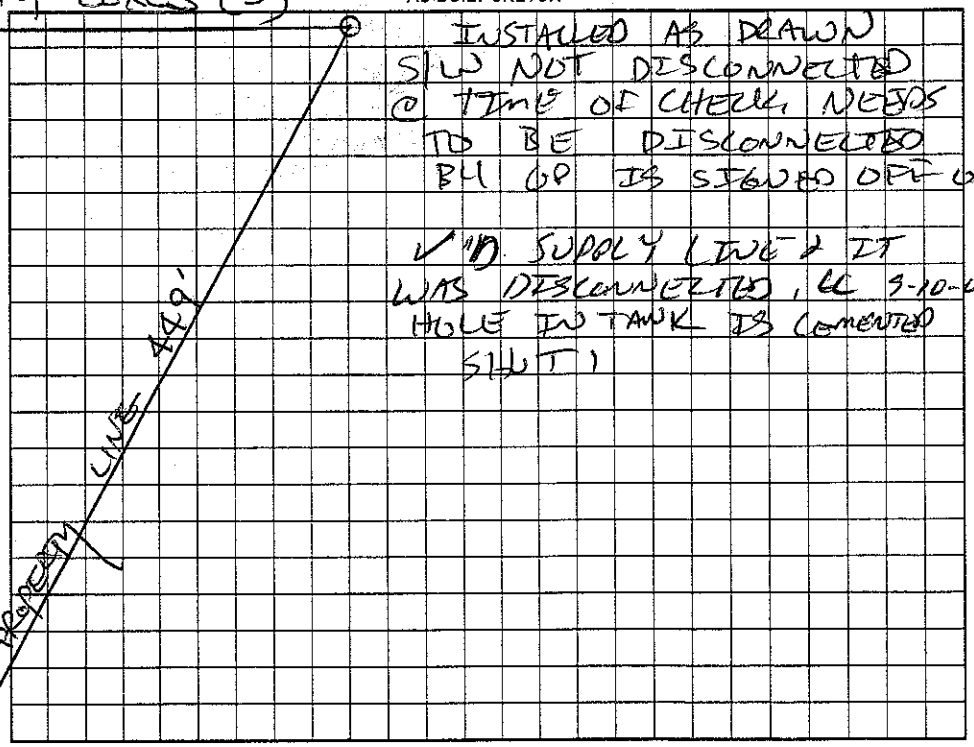

Permit can be suspended or revoked if any false information is supplied toward securing the permit/any unauthorized changes are made to the site/any unauthorized changes are made in the installation of the system. Improvement Permit with plat valid without expiration. Improvement Permit with site plan valid for sixty months. Authorization to Construct is valid for a period equal to that of Improvement Permit – not to exceed sixty months.

Signed: Earl Trent date 3-21-03 Installed by: SAMMY REAVIS

Improvement Permit by: STEVE HEDRICK date 3-21-03 Operation Permit by: date 9-10-03

Authorization to Construct by: STEVE HEDRICK date 3-21-03 Existing System Inspection by: date

HEALTH DEPT. COPY: WHITE OWNER COPY (FINAL): YELLOW OWNER COPY (INITIAL): PINK