IREDELL COUNTY HEALTH DEPARTMENT

Statesville Office (704) 878-5305 Mooresville Office (704) 660-3625 PERMIT # 210251

IMPROVEMENT PERMIT / AUTHORIZATION TO CONSTRUCT / OPERATION PERMIT / EXISTING SYSTEM

PIN # 4891153838

APPLICANT: ERNEST WHITE APPLICANT ADDRESS: 263 HAMLETT RD HARMONY NC 28634

SITE ADDRESS: 263 HAMLET RD HARMONY NC 28634 PHONE: 7049028433 ALT. PHONE: N/A

SITE DIRECTIONS: 21 N (R) Powell Bridge (R) Hamlett (L) at Box #263


SUBDIVISION: N/A SECTION: N/A LOT # N/A LOT AREA: 1.895 AC DESIGN FLOW: 240 L.T.A.R.: .3

Septic Tank	1000 (gal)	STB 1012-1060	Date 1-23-15	☒ New System ☐ Repair ☐ Expansion	System Type: I II (III) IV V VI	☒ Residence	No. Bedrooms	2	Water Supply
Pump Tank	(gal)	PT	Date	System Description: GRAVITY 25% REDUCTION		☐ Business	No. Persons	3	☒ Private Existing
Pump Make	Model		Serial #	Repair System Description: GRAVITY 25% REDUCTION		☐ Other	No. Employees		☐ Public
# Nitrification Fields 1	# Lines 2		Linear Ft: 200'	Maintenance Agreement Required:	☐ YES ☒ NO	☒ Slab	☐ Crawl Space		☐ Community
Trench Width 36"	Max. Trench Bottom Depth 36"		Gravel Depth N/A	☒ GRAVITY	☐ PRESSURE	☐ Basement w/plumbing		☐ Basement w/o plumbing	


Comments / Conditions: (1) MAINTAIN 15' SIDE SLOPE SETBACK FROM BUILDING. Positive Drainage and septic system. (2) Install lines in contours as drawn and maintain all setbacks. (3) Grade out Berm As noted. (4) OWNER REQUESTED 25% REDUCTION

(5) Building is being converted into home / 2 BEDROOMS

INITIAL SITE SKETCH

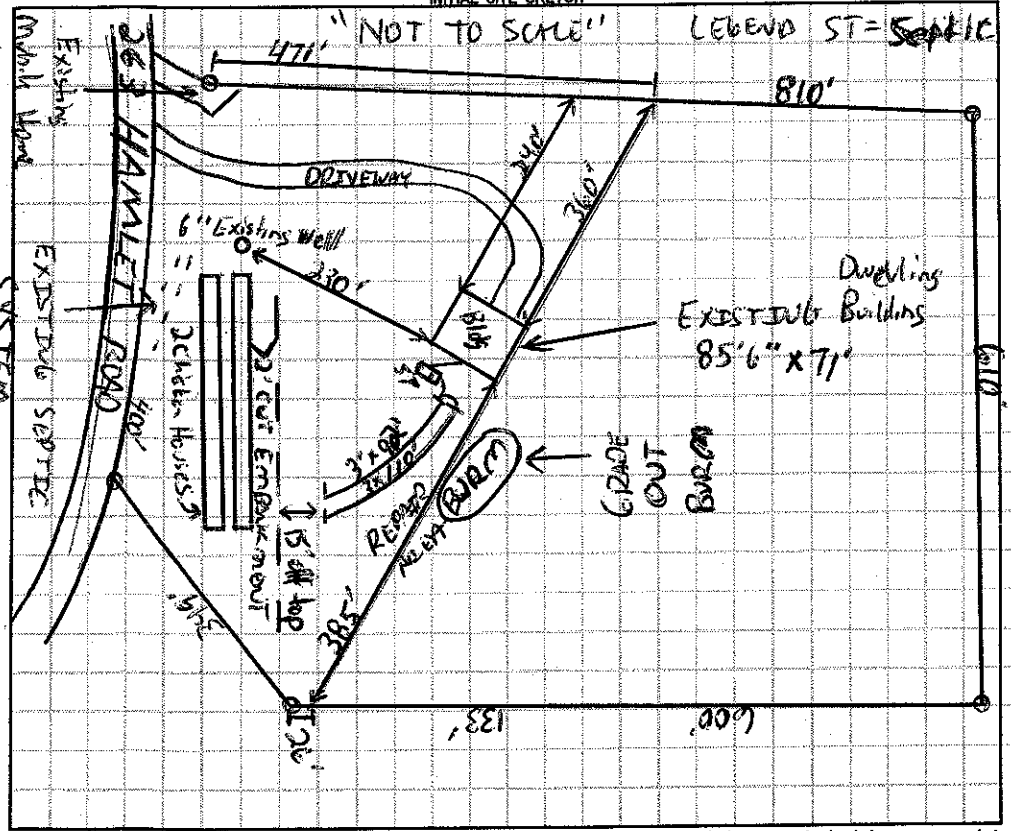

AS BUILT SKETCH

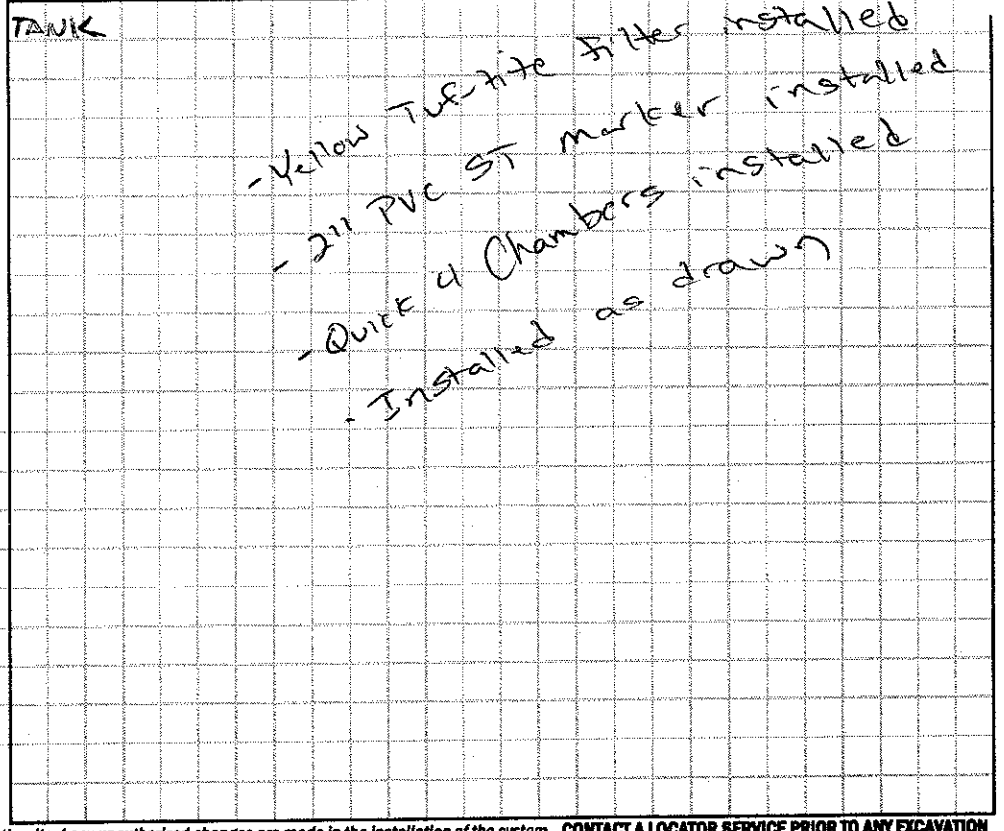

Permit can be suspended or revoked if any false information is supplied toward securing the permit / any unauthorized changes are made to the site / any unauthorized changes are made in the installation of the system. **CONTACT A LOCATOR SERVICE PRIOR TO ANY EXCAVATION**

☐ **IMPROVEMENT PERMIT** *with plat valid without expiration.* ☒ **IMPROVEMENT PERMIT** *with site plan valid for 60 mos.* ☒ **AUTHORIZATION TO CONSTRUCT** *valid for period equal to IMPROVEMENT PERMIT--not to exceed 60 mo.*

Owner / Applicant Signature: Linda Rae White Date: 6-5-15 Installed by: Tommy Frye

IMPROVEMENT PERMIT by: Date: 6-5-15 OPERATION PERMIT by: Date: 7-16-15

AUTHORIZATION TO CONSTRUCT by: Date: 6-8-15 Existing System Inspected by: Date:

Health Dept. Copy - WHITE Applicant (Final Approval) - YELLOW Applicant (Conditional Approval) - PINK