IREDELL COUNTY HEALTH DEPARTMENT

Statesville Office (704) 878-5305 Mooresville Office (704) 660-3625 PERMIT # 202822

IMPROVEMENT PERMIT / AUTHORIZATION TO CONSTRUCT / OPERATION PERMIT / EXISTING SYSTEM

PIN # 4891538838

APPLICANT: Ernest White APPLICANT ADDRESS: 263 Hamlet Rd.

SITE ADDRESS: 263 Hamlet Rd PHONE: 704-902-8433 ALT. PHONE: N/A

SITE DIRECTIONS: Hwy 21 N TR Powell Bridge Rd TR Hamlet Rd Property on Left.


SUBDIVISION: N/A SECTION: N/A LOT # N/A LOT AREA: 4.238 DESIGN FLOW: 240gpd L.T.A.R.: 0.275

Septic Tank	Existing (gal)	STB		Date		☐ New System ☐ Repair ☑ Expansion	System Type: I II III IV V VI	☑ Residence	No. Bedrooms 2
Pump Tank	(gal)	PT		Date		System Description: 25% Reduction		☐ Business	No. Persons 4
Pump Make		Model		Serial #		Repair System Description: 25% Reduction (Pump)		☐ Other	No. Employees
# Nitrification Fields	1	# Lines	2	Linear Ft:	128	Maintenance Agreement Required:	☐ YES ☑ NO	☐ Slab	☑ Crawl Space
Trench Width	36"	Max. Trench Bottom Depth	36"	Gravel Depth	N/A	☑ GRAVITY	☐ PRESSURE	☐ Basement w/plumbing	☐ Basement w/o plumbing


Water Supply: ☑ Private ☐ Public ☐ Community

Comments / Conditions: Install a 25% Reduction system on contour with Serial distribution. Remove existing SWMH from septic system prior to connecting New Home to septic systems.

INITIAL SITE SKETCH

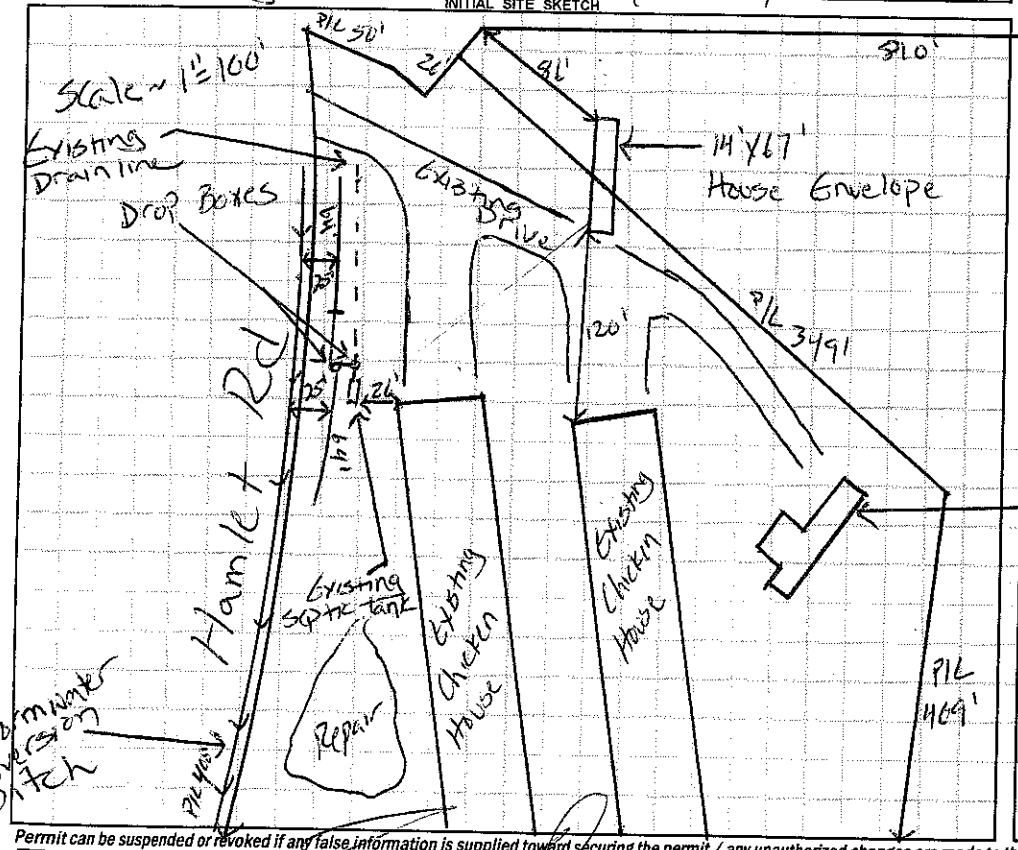

AS BUILT SKETCH

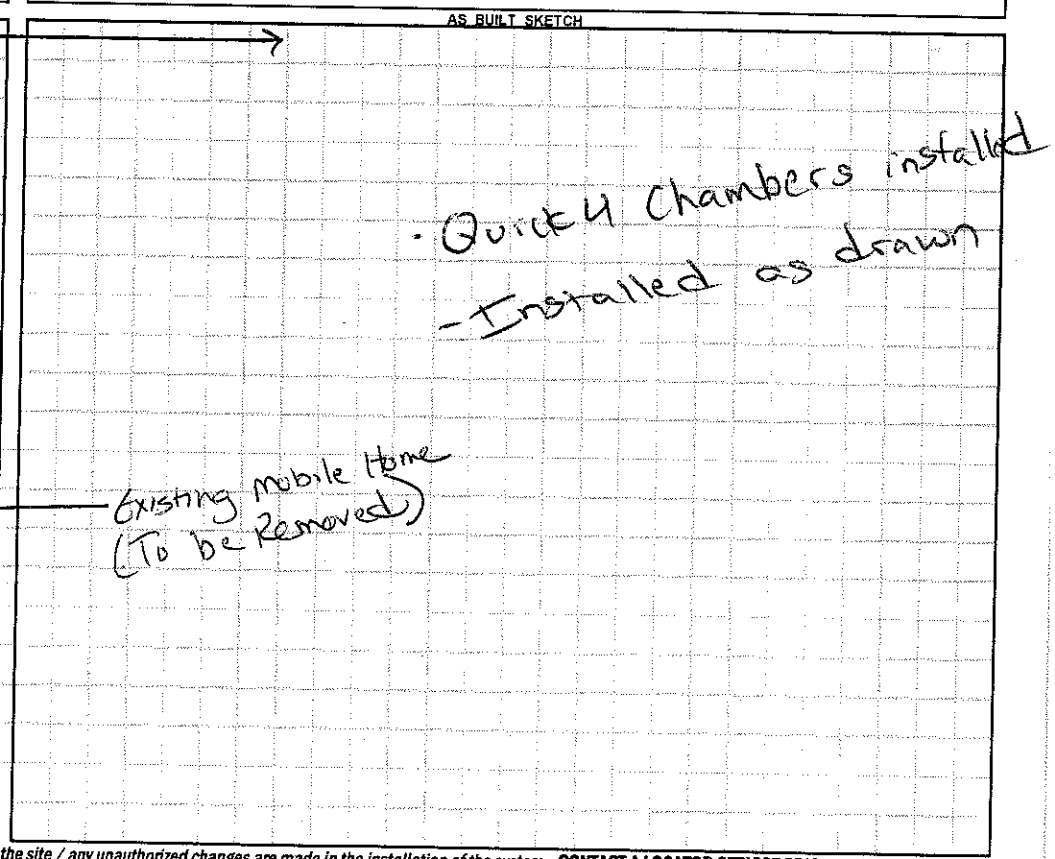

Permit can be suspended or revoked if any false information is supplied toward securing the permit / any unauthorized changes are made to the site / any unauthorized changes are made in the installation of the system. **CONTACT A LOCATOR SERVICE PRIOR TO ANY EXCAVATION**

☐ **IMPROVEMENT PERMIT** *with plat valid without expiration* ☑ **IMPROVEMENT PERMIT** *with site plan valid for 60 mos.* ☑ **AUTHORIZATION TO CONSTRUCT** *valid for period equal to IMPROVEMENT PERMIT--not to exceed 60 mo.*

Owner / Applicant Signature: Date:

IMPROVEMENT PERMIT by: Justin Henderson Date: 6-2-14

AUTHORIZATION TO CONSTRUCT by: Justin Henderson Date: 6-2-14

Installed by: Tommy Frye

OPERATION PERMIT by: Justin Henderson Date: 6-4-14

Existing System Inspected by: Date:

Health Dept. Copy - WHITE Applicant (Final Approval) - YELLOW Applicant (Conditional Approval) - PINK