80965 (MH-tiedown/withdrawn)

IREDELL COUNTY HEALTH DEPARTMENT

STATESVILLE 704-878-5305 MOORESVILLE 704-664-5281

IMPROVEMENT PERMIT / AUTHORIZATION TO CONSTRUCT / OPERATION PERMIT / EXISTING SYSTEM INSPECTION

PERMIT# 080227 PIN# 4891 22 7318 DATE 4-1-99

OWNER OR CONTRACTOR RANDAL HATFIELD PHONE: Business Home 546-2711

ADDRESS 733 SHEFFIELD ROAD, HARMONY NC 28634

LOCATION US 21 N, TR NC 901, TL SHEFFIELD ROAD, ON LEFT JUST PAST RAVEN RD, ~1200 FT OFF ROAD

SUBDIVISION BLOCK / SECTION LOT LOT AREA 53.88 ACRES SITE CLASS PS DESIGN FLOW 360 L.T.A.R. 0.33 GAD/FT²

Septic Tank: 1000 Gallons; STB 760 Date 1-16-99
Pump Tank: Gallons; PT Date
Pump Make: Model Serial No.
Nitrification Field: No Fields 1 Square Feet 1080 Linear Feet 360
No Lines SIX Trench Width 36" Max Trench Bottom Depth 26" Gravel Depth 12"

(✓) New System ( ) Repair System Type I II III IV V VI
System Description: CONVENTIONAL GRAVITY
Repair System Description: CONV. GRAVITY
Maintenance Agreement Required: ( ) Yes (✓) No
( ) Slab ( ) Crawl Space (✓) Basement w/plumbing ( ) Basement wo/plumbing


( ) House/Mod. Home No. Bedrooms 3
( ) Mobile Home No. Bathrooms 3½
( ) Business No. Employees
( ) Other

Water Supply: ( ) Individual ( ) Public ( ) Community WELL


Comments/Conditions: ① USE ONE FLOW DIVIDER TEE TO ACHIEVE EQUAL DISTRIBUTION INTO EACH OF TWO SERIES OF DROP BOXES FEEDING THREE LINES ② TEMPORARY MH TO BE REMOVED UPON OCCUPANCY OF HOUSE

Comments/Conditions: ① SEPTIC TANK WITH RISERS INSTALLED WITH "POLYLOK" FILTER ② DISTRIBUTION BOXES USED IN PLACE OF DROP BOXES

INITIAL SITE SKETCH SCALE: 1"=40'

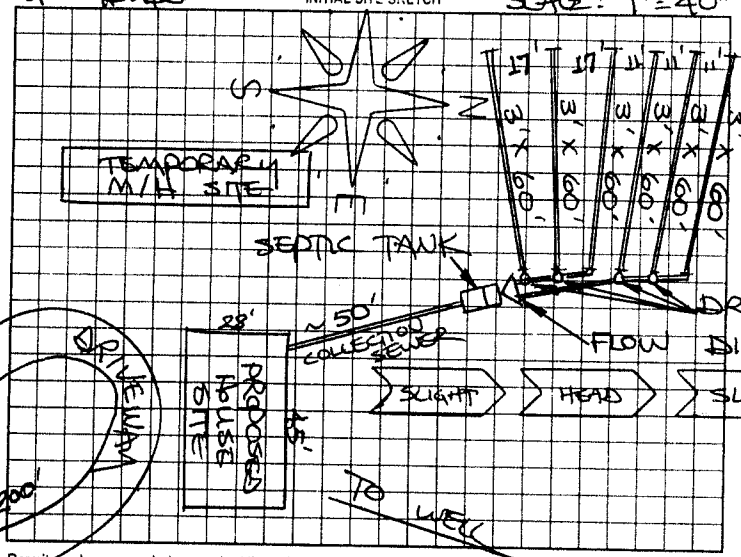

AS BUILT SKETCH

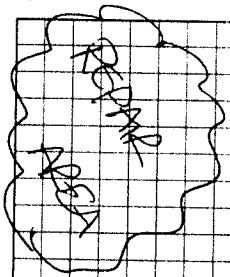

SYSTEM INSTALLED ACCORDING TO INITAL SITE SKETCH

Permit can be suspended or revoked if any false information is supplied toward securing the permit/any unauthorized changes are made to the site/any unauthorized changes are made in the installation of the system. Improvement Permit with plat valid without expiration. Improvement Permit with site plan valid for sixty months. Authorization to Construct is valid for a period equal to that of Improvement Permit – not to exceed sixty months.

Signed: T Randal Hatfield date 4-1-99

Improvement Permit by: STEVE HEDRICK date 4-1-99

Authorization to Construct by: STEVE HEDRICK date 4-1-99

Installed by: SHERMAN DUNN

Operation Permit by: STEVE HEDRICK date 4-20-99

Existing System Inspection by: date

HEALTH DEPT COPY: WHITE OWNER COPY (FINAL): YELLOW OWNER COPY (INITIAL): PINK