IREDELL COUNTY HEALTH DEPARTMENT

STATESVILLE 704-878-5305 (a) MOORESVILLE 704-664-5281

IMPROVEMENT PERMIT / AUTHORIZATION TO CONSTRUCT / OPERATION PERMIT / EXISTING SYSTEM INSPECTION

PERMIT# 128205 PIN# 4891-30-0991 11020 DATE 7-5-05

OWNER OR CONTRACTOR JERRY & KIMBERLEY McDANIEL PHONE: Business (704) 873-0525 Home

ADDRESS 755 SHEFFIELD RD. HARMONY, NC 28634

LOCATION I-77N TO HWY 901 TL SHEFFIELD, ON LEFT

SUBDIVISION BLOCK / SECTION LOT LOT AREA 0.783 SITE CLASS. PS DESIGN FLOW 480 L.T.A.R. 0.30 GPD/FT²

Septic Tank: EXISTING Gallons; STB Date

Pump Tank: Gallons; PT Date

Pump Make: Model Serial No.

Nitrification Field: No Fields 1 Square Feet 1600 Linear Feet 540

No Lines THREE (3) Trench Width 36" Max Trench Bottom Depth 36" Gravel Depth 12"

☑ New System ☐ Repair System Type: I (II) III, IV, V, VI

System Description: CONVENTIONAL GRAVITY

Repair System Description: PUMP 25% REDUCTION

Maintenance Agreement Required: ☐ Yes ☑ No

☐ House/Mod. Home No. Bedrooms 4

☑ Mobile Home No. Bathrooms

☐ Business No. Employees

☐ Other


☐ Slab ☑ Crawl Space ☐ Basement w/plumbing ☐ Basement wo/plumbing

Water Supply: ☐ Individual ☐ Public ☐ Community


Comments:/Conditions: (1) INSTALL SYSTEM ON CONTOUR (2) MAINTAIN SETBACKS FROM WELL & DRAINAGE DITCH (3) TANK WILL REQUIRE RISER TO BE INSTALLED AT LEAST 6" ABOVE GRADE. (4) D-BOX EXISTING REQUIRES SPEED LEVELERS TO BE INSTALLED TO FEED FIRST LINE

Comments:/Conditions:

INITIAL SITE SKETCH

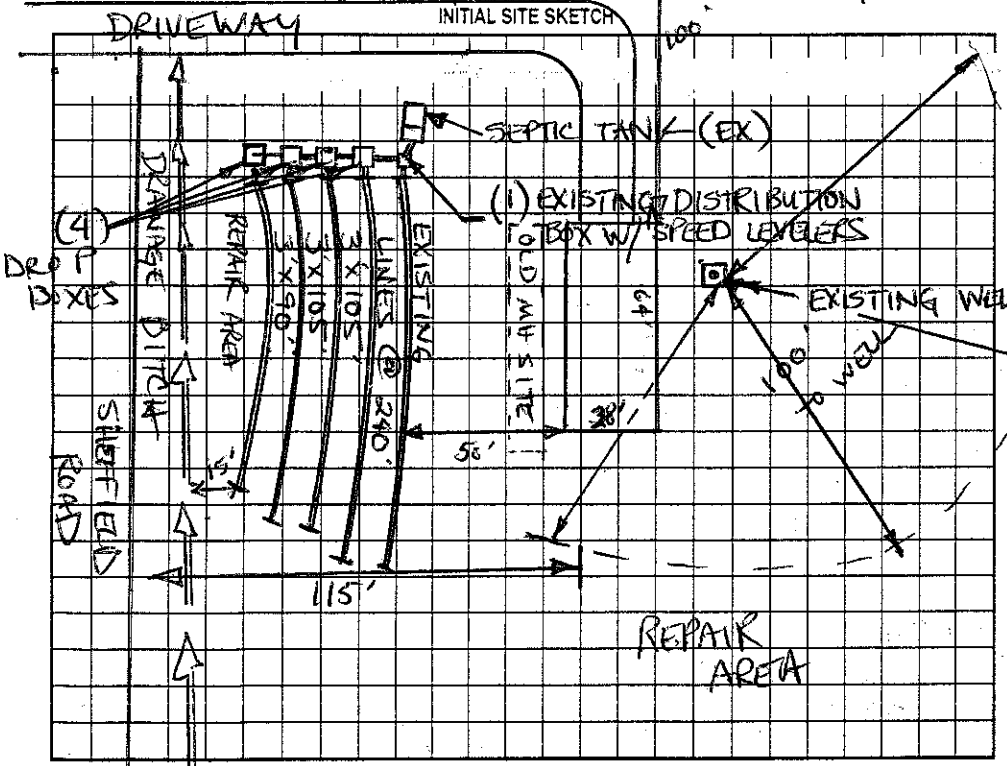

AS BUILT SKETCH

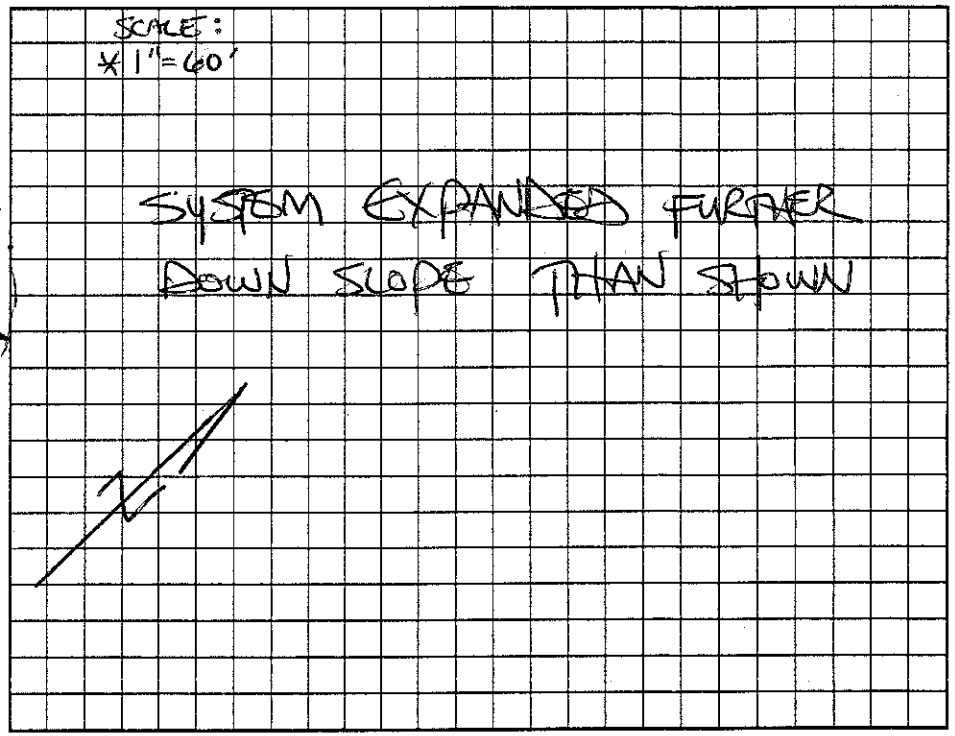

Permit can be suspended or revoked if any false information is supplied toward securing the permit/any unauthorized changes are made to the site/any unauthorized changes are made in the installation of the system. Improvement Permit with plat valid without expiration. Improvement Permit with site plan valid for sixty months. Authorization to Construct is valid for a period equal to that of Improvement Permit – not to exceed sixty months.

Signed: date 7-5-05 Installed by: SAMMY REAVIS

Improvement Permit by: Christopher M. Sherrill REHS date 7-5-05 Operation Permit by: STEVE HENDRICK date 8-2-05

Authorization to Construct by: Christopher M. Sherrill REHS date 7-5-05 Existing System Inspection by: date

HEALTH DEPT. COPY: WHITE OWNER COPY (FINAL): YELLOW OWNER COPY (INITIAL): PINK