IREDELL COUNTY HEALTH DEPARTMENT

STATESVILLE 704-878-5305 MOORESVILLE 704-664-5281

IMPROVEMENT PERMIT / CERTIFICATE OF COMPLETION / OPERATION PERMIT / EXISTING SYSTEM INSPECTION

PROPERTY DESCRIPTION NO. REPAIR DATE 4-16-96 TAX MAP NO. Watershed: ☐ Yes ☒ No

OWNER OR CONTRACTOR WEBSTER SMITH PHONE: Business Home 546-2480

ADDRESS 874 POWELL BRIDGE ROAD, HARMONY NC 28677

LOCATION US21 N, TR POWELL BRIDGE ROAD, ON R AT BOX # 874

SUBDIVISION BLOCK / SECTION LOT LOT AREA AMPLE SITE CLASS. PS DESIGN FLOW 360 L.T.A.R. EXISTING

Septic Tank: 1000 Gallons; STB Date

Pump Tank: Gallons; PT Date

Pump Make: Model Serial No.

Nitrification Field: No Fields 1 Square Feet 300 Linear Feet 100

No Lines 1 Trench Width 36" Max Trench Bottom Depth 18-36" Gravel Depth 12"

☐ New System ☒ Repair System Type: I, II, III, IV, V, VI

System Description:

Repair System Description: CONV. GRAVITY

Maintenance Agreement Required: ☐ Yes ☒ No

☒ House/Mod. Home No. Bedrooms 3

☐ Mobile Home No. Bathrooms 1

☐ Business No. Employees

☐ Other


☐ Slab ☒ Crawl Space ☐ Basement w/plumbing ☒ Basement wo/plumbing

Water Supply: ☒ Individual ☐ Community ☐ Public WELL

Comments:

Comments:

INITIAL SITE SKETCH

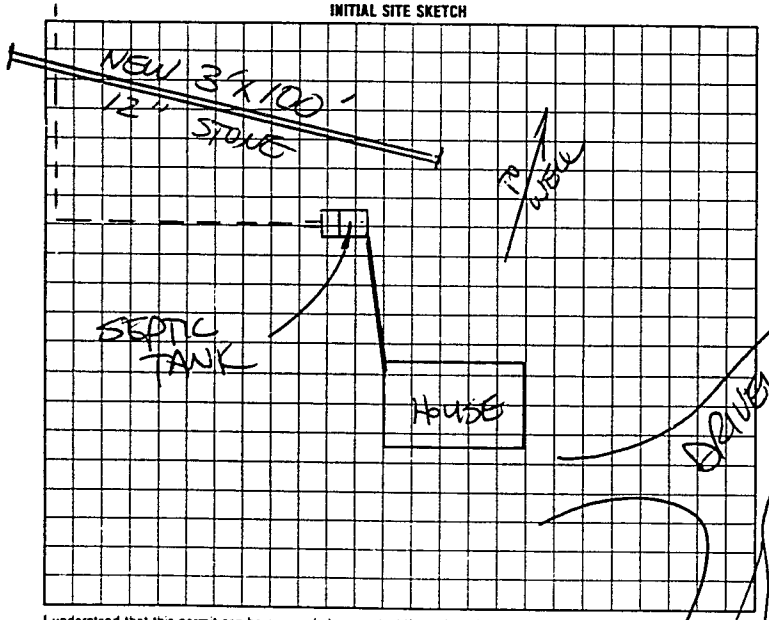

AS BUILT SKETCH

SYSTEM REPAIRED ACCORDING TO INITAL SITE SKETCH

I understand that this permit can be suspended or revoked if any false information is supplied toward securing the permit/any unauthorized changes are made to the site/any unauthorized changes are made in the installation of the system.

Authorization to construct is valid five (5) years from date of issuance. Improvement Permit has no expiration date.

Signed: Webster Smith

Improvement Permit by: STEVE HEDRICK date 4-16-96

Final Authorization to Construct: STEVE HEDRICK date 4-16-96

Installed by: SAMMY REAVIS

Certificate of Completion by: date

Operation Permit by STEVE HEDRICK date 7-5-96

HEALTH DEPT COPY: WHITE INSPECTION COPY (FINAL): GREEN OWNER COPY (FINAL): YELLOW INSPECTION COPY (INITIAL): PINK OWNER COPY (INITIAL): GOLD