Lynn Niblock 928-2017

IREDELL COUNTY HEALTH DEPARTMENT

STATESVILLE 704-878-5305 MOORESVILLE 704-664-5281

IMPROVEMENT PERMIT / AUTHORIZATION TO CONSTRUCT / OPERATION PERMIT / EXISTING SYSTEM INSPECTION

PERMIT # 145975 PIN # 4891402280 DATE 3-22-10

OWNER or APPLICANT REX Davis PHONE: Business ~~7042529583~~ Home: ~~7045465513~~ / 704657-8703

OWNER or APPLICANT ADDRESS 110 Jonethel Drive Harmony NC 28634

LOCATION / DIRECTIONS 21 N (R) 901 (L) Sheffield (R) Jonethel on LEFT

SUBDIVISION _____ BLOCK / SECTION _____ LOT # _____ LOT AREA 4.27 DESIGN FLOW 360 L.T.A.R. 125

Septic Tank 1000 Gallons: STB 851 Date 10-24-09

Pump Tank _____ Gallons: PT _____ Date _____

Pump Make _____ Model _____ Serial # _____

Nitrification Field No Fields 1 No Lines 2 Linear Feet 360'

Trench Width 36" Max. Trench Bottom Depth 36" Gravel Depth N/A

☒ New System ☐ Repair ☐ Expansion System Type I II (III) IV V VI

System Description: 62 WIDE 25% REDUCTION

Repair System Description: PUMP TO 25% REDUCTION

Maintenance Agreement Required ☐ YES ☒ NO

☒ GRAVITY ☐ PRESSURE

☒ Residence No. Bedrooms 3

☐ Business No. Persons 4

☐ Other No. Employees _____

☐ Slab ☒ Crawl Space


☐ Basement w/plumbing ☐ Basement w/o plumbing

Water Supply: ☐ Private ☒ Public ☐ Community


Comments / Conditions (1) House staked by planning & zoning office (2) S/W set up to close to front R/W Need revised to this location drawn. (3) This is a saprolite system and all wells must 100' minimum from septic and repair (4) System is flagged

Comments / Conditions out completely. (5) MAINTAIN SETBACKS (6) Install 2 Lines 180' long Fed By 2 Drop Boxes and 1 Flow Divider Tee as Drawn (7) N/K IS Already set but must be checked.

INITIAL SITE SKETCH

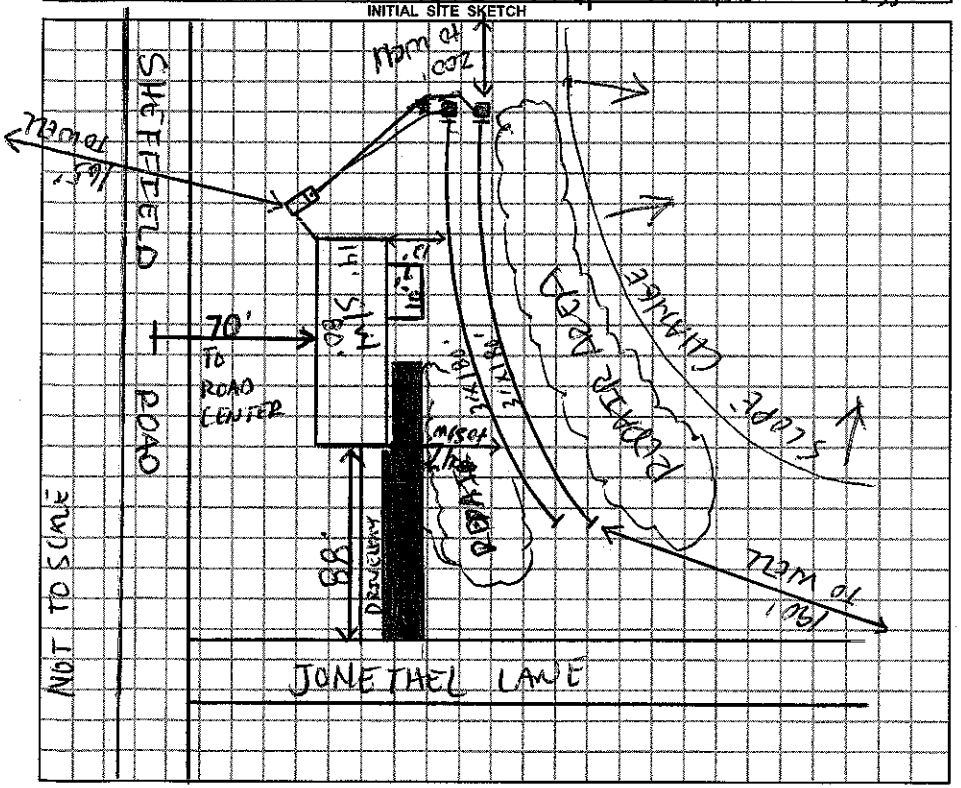

AS BUILT SKETCH

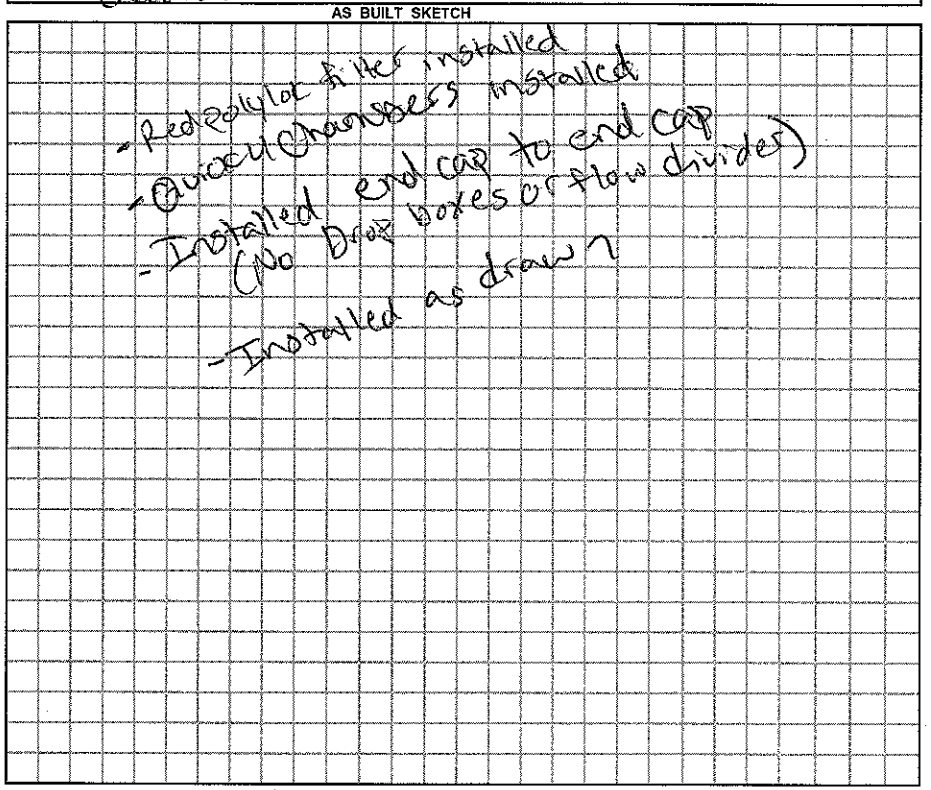

Permit can be suspended or revoked if any false information is supplied toward securing the permit / any unauthorized changes are made to the site / any unauthorized changes are made in the installation of the system.

☐ *IMPROVEMENT PERMIT w / plat valid without expiration.* ☒ *IMPROVEMENT PERMIT w / site plan valid for 60 mos.* ☒ *AUTHORIZATION TO CONSTRUCT valid for period equal to IMPROVEMENT PERMIT-not to exceed 60 mo.*

Owner / Applicant Signature: REX DAVIS Date 9/1/10

Improvement Permit by: [signature] Date 3-22-10

Authorization to Construct by: R. STEVE HENDRICK Date 9/2/2010

Installed by: Sherman Dunn

Operation Permit by: [signature] Date: 4-11-13

Existing System Inspected by: _____ Date: _____

YOU SHOULD CONTACT A LOCATOR SERVICE PRIOR TO ANY EXCAVATION.

WHITE COPY Environmental Health YELLOW COPY (Final) Owner / Applicant PINK COPY (Initial) Owner / Applicant