IREDELL COUNTY HEALTH DEPARTMENT

STATESVILLE 704-878-5305 MOORESVILLE 704-664-5281 57072

IMPROVEMENT PERMIT / CERTIFICATE OF COMPLETION / OPERATION PERMIT / EXISTING SYSTEM INSPECTION

PROPERTY DESCRIPTION NO. 21359 DATE 6/14/95 TAX MAP NO. 17B-A-49 (PART) Watershed: ☐ Yes ☐ No

OWNER OR CONTRACTOR JOSHUA EBRIGHT PHONE: Business Home (910) 998-6469

ADDRESS 142 EBRIGHT LANE, ADVANCE, NC. 27006

LOCATION US 21 N, TR NC901, TL SHEFFIELD RD, 1ST LOT ON LEFT PAST ROCK SPRINGS ROAD

SUBDIVISION BLOCK / SECTION LOT LOT AREA 1.47 ACRES SITE CLASS. PS DESIGN FLOW 360 L.T.A.R. 0.30 GPD/FT²

Septic Tank: 1000 Gallons; STB 760 Date 7-29-95
Pump Tank: Gallons; PT Date
Pump Make: Model Serial No.
Nitrification Field: No Fields 1 Square Feet 1200 Linear Feet 400
No Lines 4 Trench Width 36" Max Trench Bottom Depth 18-36" Gravel Depth 12"

☑ New System ☐ Repair System Type: I, II, III, IV, V, VI
System Description: CONVENTIONAL GRAVITY
Repair System Description: CONV. GRAVITY
Maintenance Agreement Required: ☐ Yes ☑ No

☑ House/Mod. Home No. Bedrooms 3
☐ Mobile Home No. Bathrooms 2
☐ Business No. Employees
☐ Other


☐ Slab ☑ Crawl Space ☐ Basement w/plumbing ☐ Basement wo/plumbing

Water Supply: ☑ Individual ☐ Community ☐ Public WELL

Comments: ① KEEP SYSTEM MINIMUM 5' FROM HOUSE, 100' FROM WELL, 10' FROM PROPERTY LINE ② INSTALL LINES ON CONTOUR, NO DEEPER THAN 36"

Comments:

INITIAL SITE SKETCH

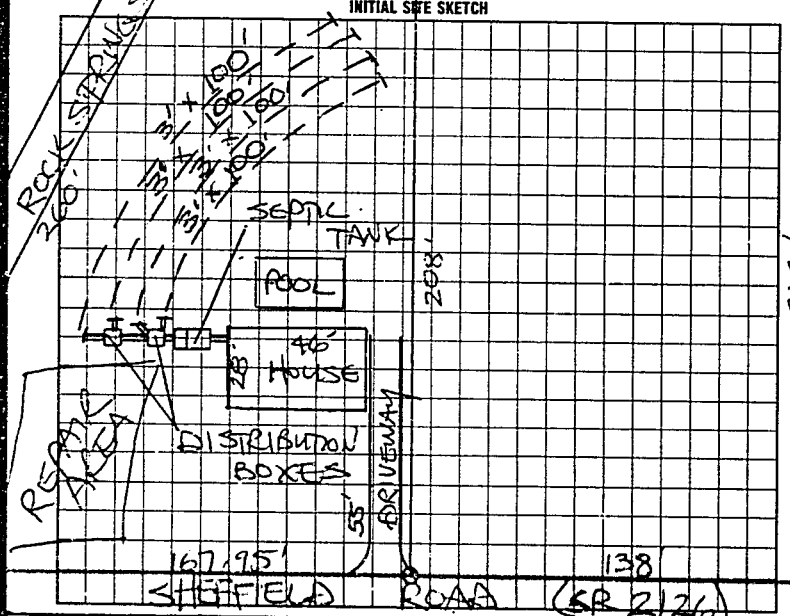

AS BUILT SKETCH

SYSTEM INSTALLED ACCORDING TO INITIAL SITE SKETCH

I understand that this permit can be suspended or revoked if any false information is supplied toward securing the permit/any unauthorized changes are made to the site/any unauthorized changes are made in the installation of the system. Improvement Permit is valid for 60 months from date of issuance.

Signed: Joshua L. Ebright

Improvement Permit by: STEVE HEDRICK date 6/14/95

Existing System Inspection by: date

Installed by: BILLY GRIMES

~~Certificate of Completion by:~~ date

Operation Permit by STEVE HEDRICK date 10/12/95

HEALTH DEPT. COPY: WHITE INSPECTION COPY (FINAL): GREEN OWNER COPY (FINAL): YELLOW INSPECTION COPY (INITIAL): PINK OWNER COPY (INITIAL): GOLD