IREDELL COUNTY HEALTH DEPARTMENT

STATESVILLE 704-878-5305 MOORESVILLE 704-664-5281

IMPROVEMENT PERMIT / CERTIFICATE OF COMPLETION / OPERATION PERMIT / EXISTING SYSTEM INSPECTION

PROPERTY DESCRIPTION NO. 24510 DATE 8-22-96 TAX MAP NO. 17B-3-A-3 Watershed: ~~Protected~~ No

OWNER OR CONTRACTOR JERRY R. TAYLOR PHONE: Business Home (704) 731-3784

ADDRESS P.O. BOX 1897 WELCOME NC 27374

LOCATION US 21 N TR NC901, TL SHEFFIELD ROAD, 2ND LOT ON LEFT PAST ROCK SPRINGS ROAD

SUBDIVISION SHEFFIELD ACRES BLOCK / SECTION LOT 3 LOT AREA 138' x 214' SITE CLASS. RS DESIGN FLOW 360 L.T.A.R. 0.30 GPD/FT²

Septic Tank: 1000 Gallons; STB 760 Date 8-17-96

Pump Tank: Gallons; PT Date

Pump Make: Model Serial No.

Nitrification Field: No Fields 1 Square Feet 1200 Linear Feet 400

No Lines 4 Trench Width 36" Max Trench Bottom Depth 18-36" Gravel Depth 12"

☑ New System ☐ Repair System Type: I, II, III, IV, V, VI

System Description: CONVENTIONAL GRAVITY

Repair System Description: CONV. GRAVITY

Maintenance Agreement Required: ☐ Yes ☑ No

☑ House/Mod. Home No. Bedrooms 3

☑ Mobile Home No. Bathrooms 2

☐ Business No. Employees

☐ Other


☐ Slab ☑ Crawl Space ☐ Basement w/plumbing ☐ Basement wo/plumbing

Water Supply: ☑ Individual ☐ Community ☐ Public WELL


Comments: ① KEEP SYSTEM MINIMUM 100' FROM WELL ② INSTALL LINES AS FLAGGED, ON CONTOUR, NO DEEPER THAN 36", 9' MINIMUM APART ON CENTERS

Comments:

INITIAL SITE SKETCH

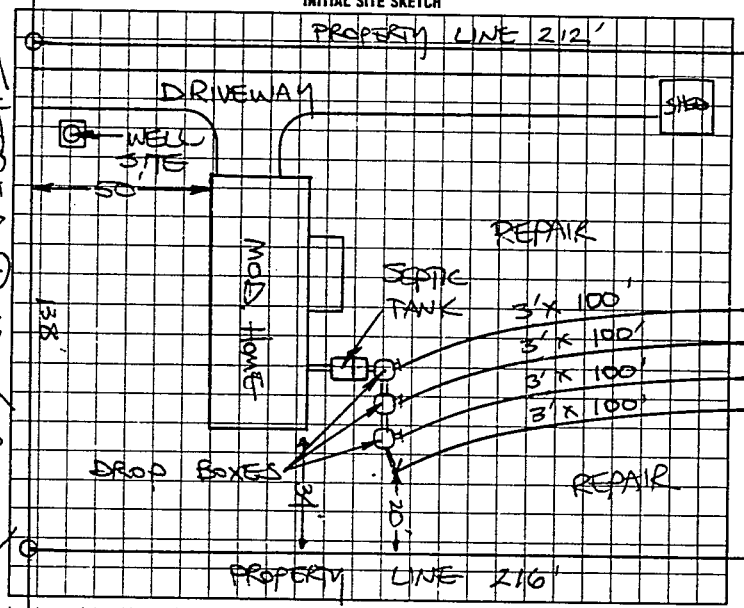

AS BUILT SKETCH

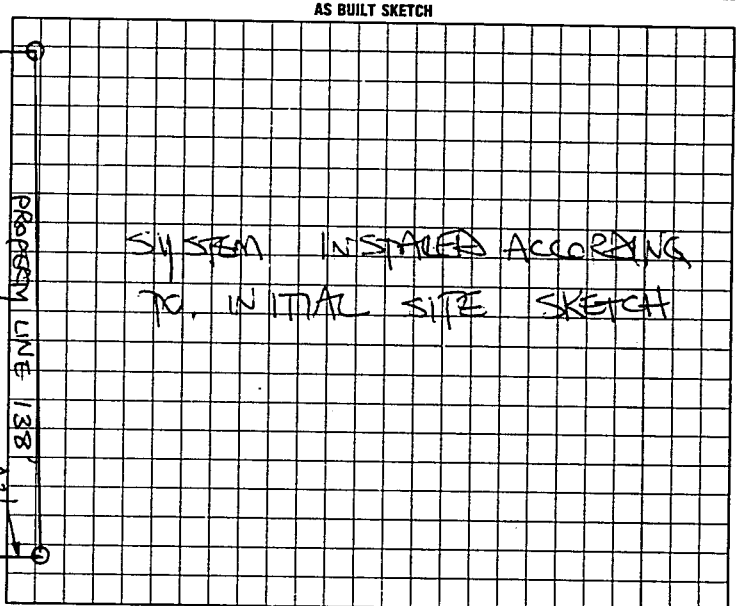

I understand that this permit can be suspended or revoked if any false information is supplied toward securing the permit/any unauthorized changes are made to the site/any unauthorized changes are made in the installation of the system.

AUTH. TO CONST. IS VALID FOR A PERIOD EQUAL TO THE VALIDITY OF THE I.P. NOT TO EXCEED FIVE YEARS. I.P. W/ SITE PLAN IS VALID FOR FIVE YEARS.

Signed: Y Jerry R Taylor Installed by: RANDY MILLER (DAVIE CO.)

Improvement Permit by: STEVE HEDRICK date 8-22-96 Certificate of Completion by: date

AUTH. TO CONST. ~~Existing System Inspection~~ by: STEVE HEDRICK date 8-22-96 Operation Permit by: STEVE HEDRICK date 1-8-97

HEALTH DEPT. COPY: WHITE INSPECTION COPY (FINAL): GREEN OWNER COPY (FINAL): YELLOW INSPECTION COPY (INITIAL): PINK OWNER COPY (INITIAL): GOLD

00253O