# IREDELL COUNTY HEALTH DEPARTMENT

STATESVILLE 704-878-5305 MOORESVILLE 704-664-5281

## IMPROVEMENT PERMIT / CERTIFICATE OF COMPLETION / OPERATION PERMIT / EXISTING SYSTEM INSPECTION

PROPERTY DESCRIPTION NO. 24524 DATE 8-22-96 TAX MAP NO. 17B-3-A-4 Watershed: ☐ Yes ☒ No

OWNER OR CONTRACTOR BILLY GRAY TAYLOR PHONE: Business Home (910) 940-5367

ADDRESS 194 AUBREY MERREL ROAD, MOCKSVILLE, NC 27028

LOCATION US 21 N, TR NC 901, TL SHEFFIELD RD, TL ROCK SPRINGS RD, 2ND LOT ON RIGHT

SUBDIVISION SHEFFIELD ACRES BLOCK / SECTION ____ LOT A LOT AREA AMPLE SITE CLASS. P3 DESIGN FLOW 360 L.T.A.R. 0.35 GAD/FT²

Septic Tank: 1000 Gallons; STB 760 Date 10/27/96

Pump Tank: ____ Gallons; PT ____ Date ____

Pump Make: ____ Model ____ Serial No. ____

Nitrification Field: No Fields 1 Square Feet 1035 Linear Feet 345

No Lines 4 Trench Width 36" Max Trench Bottom Depth 18-36" Gravel Depth 12"

☒ New System ☐ Repair System Type: I, (II), III, IV, V, VI

System Description: CONVENTIONAL GRAVITY

Repair System Description: CONV. GRAVITY

Maintenance Agreement Required: ☐ Yes ☒ No

☒ House/Mod. Home No. Bedrooms 3

☒ Mobile Home No. Bathrooms 2

☐ Business No. Employees ____

☐ Other ____


☐ Slab ☒ Gravel Space ☐ Basement w/plumbing ☐ Basement wo/plumbing

Water Supply: ☒ Individual ☐ Community ☐ Public WELL


Comments: ① KEEP SYSTEM MINIMUM 100' FROM ANY WELL ② INSTALL LINES ON CONTOUR, NO DEEPER THAN 36", 9' MINIMUM APART ON CENTERS.

Comments: SYSTEM INSTALLED ACCORDING TO INITIAL SITE SKETCH

INITIAL SITE SKETCH

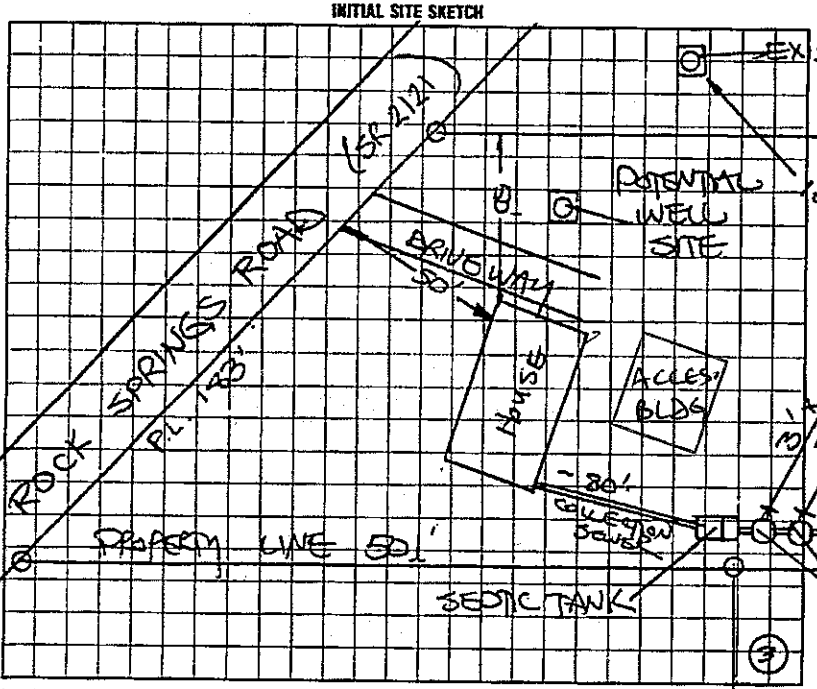


AS BUILT SKETCH

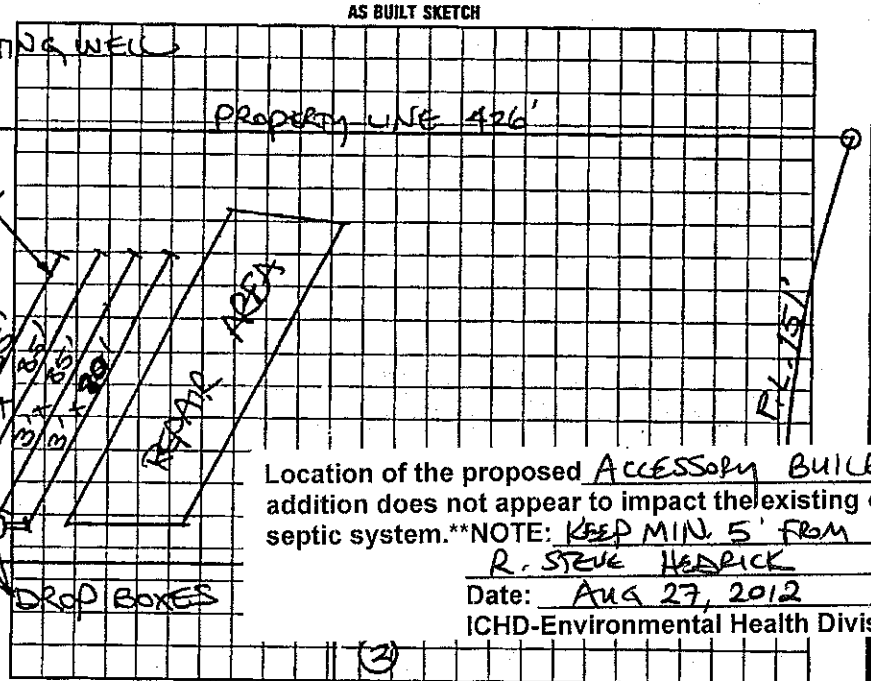


Location of the proposed ACCESSORY BUILDING addition does not appear to impact the existing on-site septic system.**NOTE: KEEP MIN. 5' FROM SYSTEM

R. STEVE HEDRICK REHS

Date: Aug 27, 2012

ICHD-Environmental Health Division

I understand that this permit can be suspended or revoked if any false information is supplied toward securing the permit/any unauthorized changes are made to the site/any unauthorized changes are made in the installation of the system.

AUTH. TO CONST. SHALL BE VALID FOR A PERIOD EQUAL TO THE VALIDITY OF THE I.P. NOT TO EXCEED FIVE YEARS. IMPROVEMENT PERMIT WITH SITE PLAN IS VALID FOR FIVE YEARS

Signed: J Billy G. Taylor

Improvement Permit by: STEVE HEDRICK date 8-22-96

AUTH. TO CONST. including system inspection by STEVE HEDRICK date 8-22-96

Installed by: RANDY MILLER (DAVIE CO.)

Certificate of Completion by: ____ date ____

Operation Permit by: STEVE HEDRICK date 12-23-96

HEALTH DEPT. COPY: WHITE INSPECTION COPY (FINAL) GREEN OWNER COPY (FINAL): YELLOW INSPECTION COPY (INITIAL): PINK OWNER COPY (INITIAL): GOLD

9 2 5 2 0 0