IREDELL COUNTY HEALTH DEPARTMENT

Statesville Office (704) 878-5305 Mooresville Office (704) 660-3625 PERMIT # 180301

IMPROVEMENT PERMIT / AUTHORIZATION TO CONSTRUCT / OPERATION PERMIT / EXISTING SYSTEM

PIN # 4891411831

APPLICANT: Clayton Homes APPLICANT ADDRESS: 828 Piedmont Drive

SITE ADDRESS: Rock Springs Rd. PHONE: 336-782-1647 ALT. PHONE: N/A

SITE DIRECTIONS: Hwy 21 N TR Hwy 901 TL Sheffield Rd. TL Rock Springs Rd.


SUBDIVISION: N/A SECTION: N/A LOT # N/A LOT AREA: 33.186 acres DESIGN FLOW: 360gpd L.T.A.R.: 0.3

Septic Tank	1000 (gal)	STB	760-1000	Date	6-9-13	☑ New System ☐ Repair ☐ Expansion	System Type: I II III IV V VI	☑ Residence	No. Bedrooms 3
Pump Tank	1000 (gal)	PT	363-1000	Date	6-24-13	System Description:	25% Reduction - Pump	☐ Business	No. Persons
Pump Make	Goulds	Model	WE0311M	Serial #	1/3 HP	Repair System Description:	25% Reduction - Pump	☐ Other	No. Employees
# Nitrification Fields	1	# Lines	3	Linear Ft:	300	Maintenance Agreement Required:	☐ YES ☑ NO	☐ Slab	☑ Crawl Space
Trench Width	36"	Max. Trench Bottom Depth	32"	Gravel Depth	N/A		☐ GRAVITY ☑ PRESSURE	☐ Basement w/plumbing	☐ Basement w/o plumbing

Water Supply: ☐ Private ☑ Public ☐ Community

Comments / Conditions: IMPROVEMENTS ONLY! Submit floor plan prior to issuance of CA. Install a 25% reduction system on contour with parallel distribution.

INITIAL SITE SKETCH

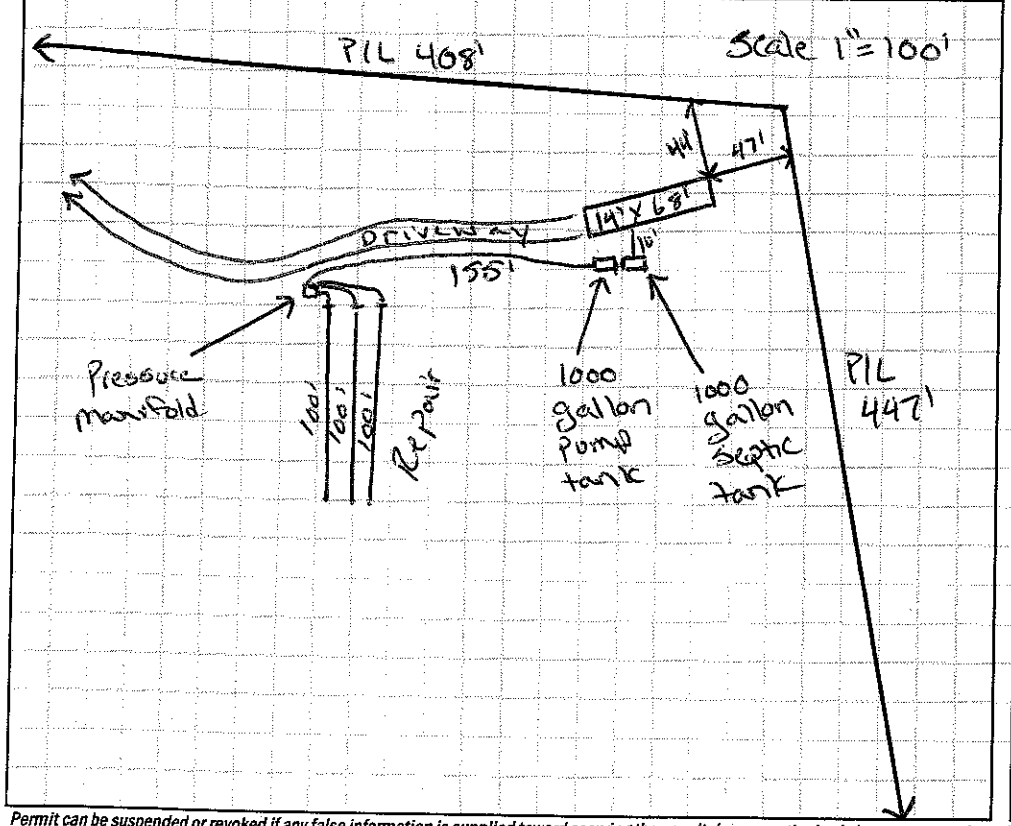

AS BUILT SKETCH

- Red Polylok filter installed
- Quick 4 Chambers installed
- Riser installed on Pump tank

	Date	Initials
Drain Lines Checked	10-14-13	JH
Tanks Checked	10-14-13	JH
Pressure Manifold or Valve Box Checked	11-25-13	JH
Pressure Head Set	11-25-13	JH
Electrical Checked	11-25-13	N/A
Floats Set	11-25-13	JH
Alarm Checked	11-25-13	JH
Maintenance Contract Y / N	N/A	N/A

Permit can be suspended or revoked if any false information is supplied toward securing the permit / any unauthorized changes are made to the site / any un...

☐ **IMPROVEMENT PERMIT** *with plat valid without expiration.* ☑ **IMPROVEMENT PERMIT** *with site plan valid for 60 mos.* ☐ **AUTHORIZATION TO CONSTRUCT** *valid for period equal to IMPROVEMENT PERMIT--not to exceed 60 mo.* **...NY EXCAVATION**

Owner / Applicant Signature: [signature] Date: 9-17-13 Installed by: A1 Backhoe

IMPROVEMENT PERMIT by: Justin Henderson Date: 8-23-13 OPERATION PERMIT by: Justin Henderson Date: 11-25-13

AUTHORIZATION TO CONSTRUCT by: Justin Henderson Date: 9-16-13 Existing System Inspected by: Date:

Health Dept. Copy - WHITE Applicant (Final Approval) - YELLOW Applicant (Conditional Approval) - PINK