IREDELL COUNTY HEALTH DEPARTMENT - *ENVIRONMENTAL HEALTH* ☑ STATESVILLE OFFICE 704-878-5305 ☐ MOORESVILLE OFFICE 704-664-5281

IMPROVEMENT PERMIT / AUTHORIZATION TO CONSTRUCT / OPERATION PERMIT / EXISTING SYSTEM INSPECTION

PERMIT # 165230 PIN # 4891-42-7172 DATE 7 MARCH 11

OWNER Dennis Shaw APPLICANT: PHONE: Home/Cell # (704) 929-5791 Business #

SITE ADDRESS Rock Springs Rd. Harmony OWNER / APPLICANT ADDRESS

SITE DIRECTIONS Memorial Hwy TL Sheffield Rd. TL Rock Springs - ON Left before Creek.

SUBDIVISION BLOCK / SECTION LOT # LOT AREA 12.67Ac. DESIGN FLOW 360 gpd L.T.A.R. 0.3 gpd/ft²

Septic Tank 1000 Gallons: STB 760 Date 6-19-10
Pump Tank Gallons: P T Date
Pump Make Model Serial #
No. Nitrification Fields: 1 No. Lines 3 Linear Feet 300
Trench Width 36" Max. Trench Bottom Depth 36" Gravel Depth N/A

☑ New System ☐ Repair ☐ Expansion System Type I II III IV V VI
System Description: 25% Reduction
Repair System Description: 25% Reduction
Maintenance Agreement Required ☐ YES ☑ NO
☑ GRAVITY ☐ PRESSURE


☑ Residence No. Bedrooms 3
☐ Business No. Persons
☐ Other No. Employees
☐ Slab ☑ Crawl Space
☐ Basement w/plumbing ☐ Basement w/o plumbing

Water Supply: ☐ Private ☑ Public ☐ Community


Comments / Conditions * Saprolite system / Shall be located 100' min. from all wells. (15NCAC 18A .1956(6)(g))

Polylock Filter / ST has risers on each comp. Inf. Hunter

INITIAL SITE SKETCH

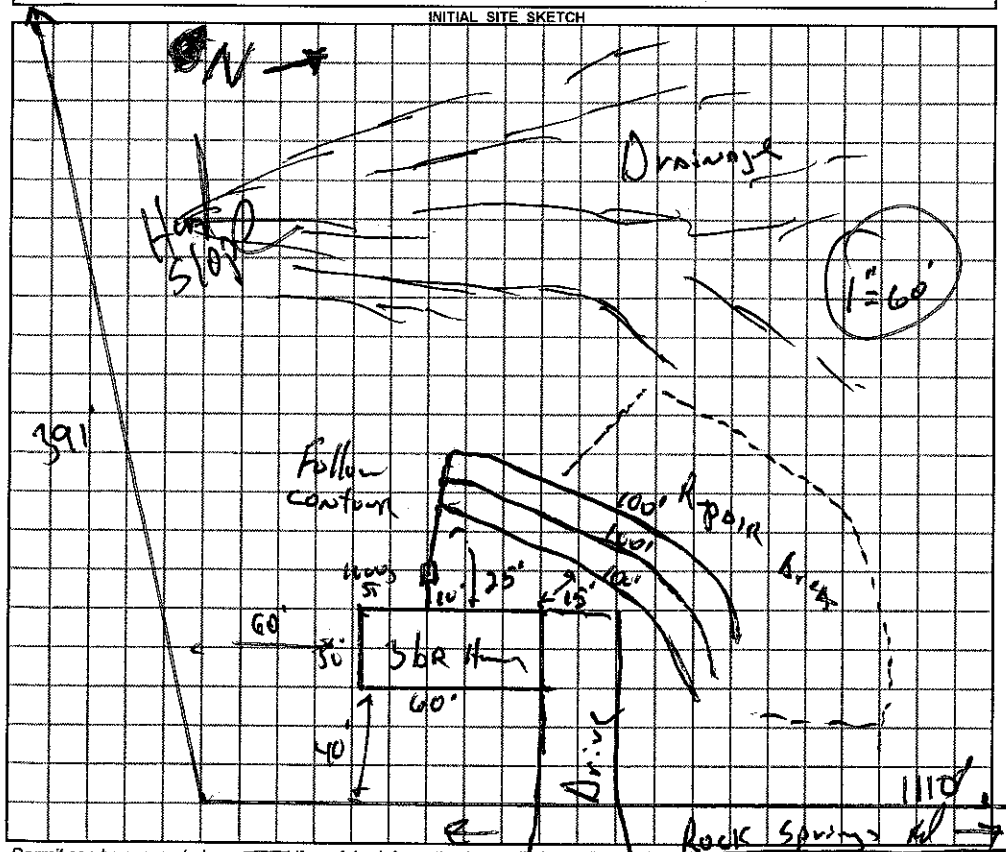

AS BUILT SKETCH

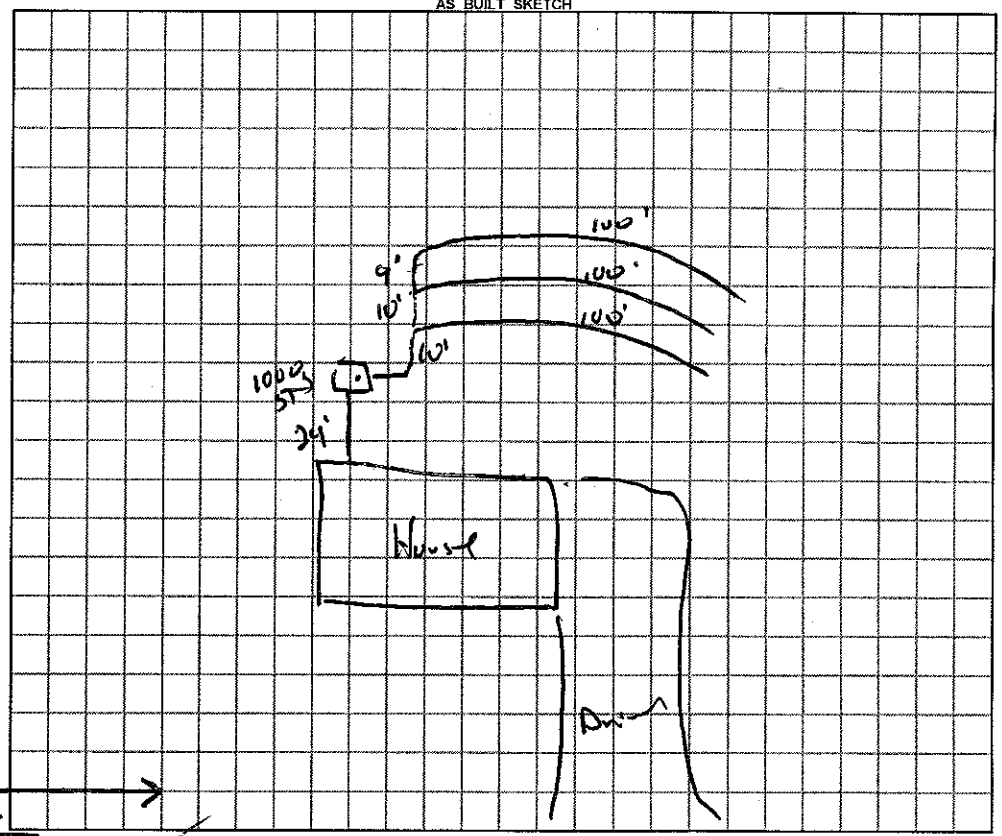

Permit can be suspended or revoked if any false information is supplied toward securing the permit / any unauthorized changes are made to the site / any unauthorized changes are made in the installation of the system.

☐ ***IMPROVEMENT PERMIT*** *with plat valid without expiration.*

☑ ***IMPROVEMENT PERMIT*** *with plat valid without expiration.* ***Site plan valid 60 mo.***

☑ ***AUTHORIZATION TO CONSTRUCT*** valid for period equal to IMPROVEMENT PERMIT--not to exceed 60 mo.

Owner / Applicant Signature: Date 3-8-11

IMPROVEMENT PERMIT by: REHS Date 7 March 11

AUTHORIZATION TO CONSTRUCT by: REHS Date 7 March 11

YOU SHOULD CONTACT A LOCATOR SERVICE PRIOR TO ANY EXCAVATION

Installed by: Bryant Gaither

OPERATION PERMIT by: REHS Date 13 April 11

Existing System Inspected by: REHS Date

White Copy – Environmental Health YELLOW COPY (Final) Owner / Applicant PINK COPY (Initial) Owner / Applicant