THIS PERMIT VOIDS PREVIOUS ISSUED 7-20-2000

IREDELL COUNTY HEALTH DEPARTMENT

STATESVILLE 704-878-5305 (1) MOORESVILLE 704-664-5281

IMPROVEMENT PERMIT / AUTHORIZATION TO CONSTRUCT / OPERATION PERMIT / EXISTING SYSTEM INSPECTION

PERMIT# 088405 PIN# 4891-51-1072 DATE 11-7-01

OWNER OR CONTRACTOR GASTON CAMPBELL PHONE. Business 1 (800) 277-4960 Home (704) 546-7393

ADDRESS P.O. BOX 417, HARMONY NC 28634

LOCATION US 21 N, TR NC901, TL SHEFFIELD RD, ON LEFT PAST ROCK SPRINGS CH. RD, OFF ROAD

SUBDIVISION _____ BLOCK / SECTION _____ LOT _____ LOT AREA 8.42 ACRES SITE CLASS PS DESIGN FLOW 360 L.T.A.R. 0.30 GPD/FT²

Septic Tank: 1000 Gallons. STB 760 Date 9-15-01
Pump Tank: _____ Gallons. PT _____ Date _____
Pump Make: _____ Model _____ Serial No _____
Nitrification Field: No Fields 1 Square Feet 1200 Linear Feet 400
No Lines FOUR Trench Width 36" Max Trench Bottom Depth 36" Gravel Depth 12"

☐ New System ☐ Repair System Type: I (II) III. IV. V. VI
System Description: CONVENTIONAL GRAVITY
Repair System Description: CONVENTIONAL, PUMP
Maintenance Agreement Required: ☐ Yes ☑ No

☐ House/Mod. Home ☑ Mobile Home ☐ Business ☐ Other
No. Bedrooms 3 No. Bathrooms 2 No. Employees ____


☐ Slab ☑ Crawl Space ☐ Basement w/plumbing ☐ Basement wo/plumbing

Water Supply: ☐ Individual ☐ Public ☐ Community

Comments/Conditions: INSTALL AS FLAGGED ON SITE

Comments/Conditions: SEPTIC TANK WITH MARKER INSTALLED USING "ZABEL" FILTER

INITIAL SITE SKETCH

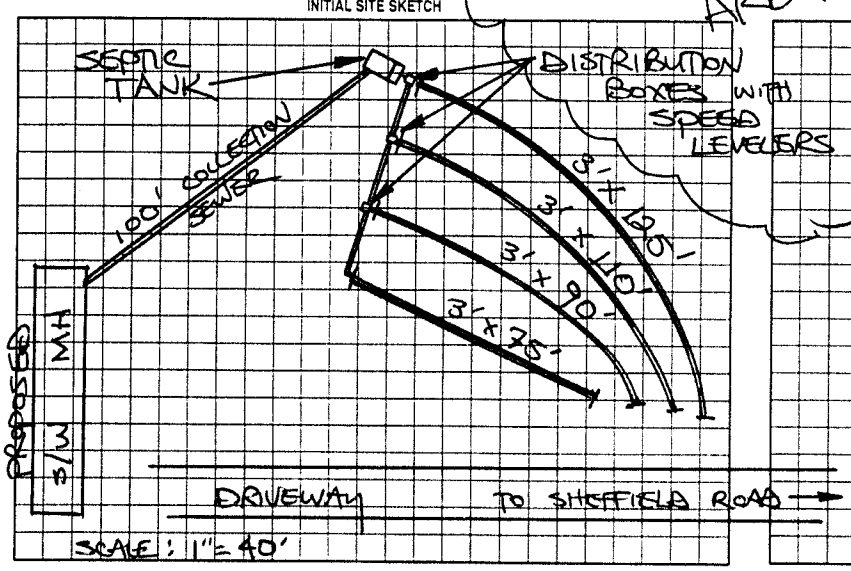

AS BUILT SKETCH

SYSTEM INSTALLED ACCORDING TO INITAL SITE SKETCH

Permit can be suspended or revoked if any false information is supplied toward securing the permit/any unauthorized changes are made to the site/any unauthorized changes are made in the installation of the system. Improvement Permit with plat valid without expiration. Improvement Permit with site plan valid for sixty months. Authorization to Construct is valid for a period equal to that of Improvement Permit – not to exceed sixty months.

Signed: Gaston S Campbell date 11-9-01

Improvement Permit by: STEVE HEDRICK date 11-7-01

Authorization to Construct by: STEVE HEDRICK date 11-7-01

Installed by: BRENT GAUTHER

Operation Permit by: STEVE HEDRICK date 12-03-01

Existing System inspection by: _____ date _____

HEALTH DEPT COPY: WHITE OWNER COPY (FINAL): YELLOW OWNER COPY (INITIAL): PINK