IREDELL COUNTY HEALTH DEPARTMENT

STATESVILLE 704-878-5305 MOORESVILLE 704-664-5281

IMPROVEMENT PERMIT / AUTHORIZATION TO CONSTRUCT / OPERATION PERMIT / EXISTING SYSTEM INSPECTION

PERMIT# 43352 PIN# 4891571072 DATE 6-14-07

OWNER OR APPLICANT Easton Campbell PHONE: Business 878 5123 Home

ADDRESS Box 11 Harmony NC 28634

LOCATION 21W (R) 901 (L) Sheffield (R) past Rockspring Church 2D RD

SUBDIVISION BLOCK / SECTION LOT LOT AREA 8.42 SITE CLASS. 5 DESIGN FLOW 360 L.T.A.R. 3

Septic Tank: 1000 Gallons; STB 700 Date 5-15-01

Pump Tank: Gallons; PT Date

Pump Make: Model Serial No.

Nitrification Field; No Fields 1 Square Feet 800 Linear Feet 400

No Lines 4 Trench Width 36" Max Trench Bottom Depth 30" Gravel Depth 12" ☐ Gravity ☐ Pressure

☐ New System ☐ Repair ☐ Expansion System Type: I (II) III IV V VI

System Description: 2-Yr Stag - Conventional Gravity

Repair System Description: Conventional Pump

Maintenance Agreement Required: ☐ Yes ☐ No

☐ House/Mod. Home No. Bedrooms 3

☐ Mobile Home No. Persons 2

☐ Business No. Employees

☐ Other

Water Supply: ☐ Individual ☐ Public ☐ Community

☐ Slab ☐ Crawl Space ☐ Basement w/plumbing ☐ Basement wo/plumbing

Comments./Conditions:

Comments:/Conditions:


Septic tank has Zabel filter

Septic tank has manhole lid

Pipe plat permit.

INITIAL SITE SKETCH

AS BUILT SKETCH

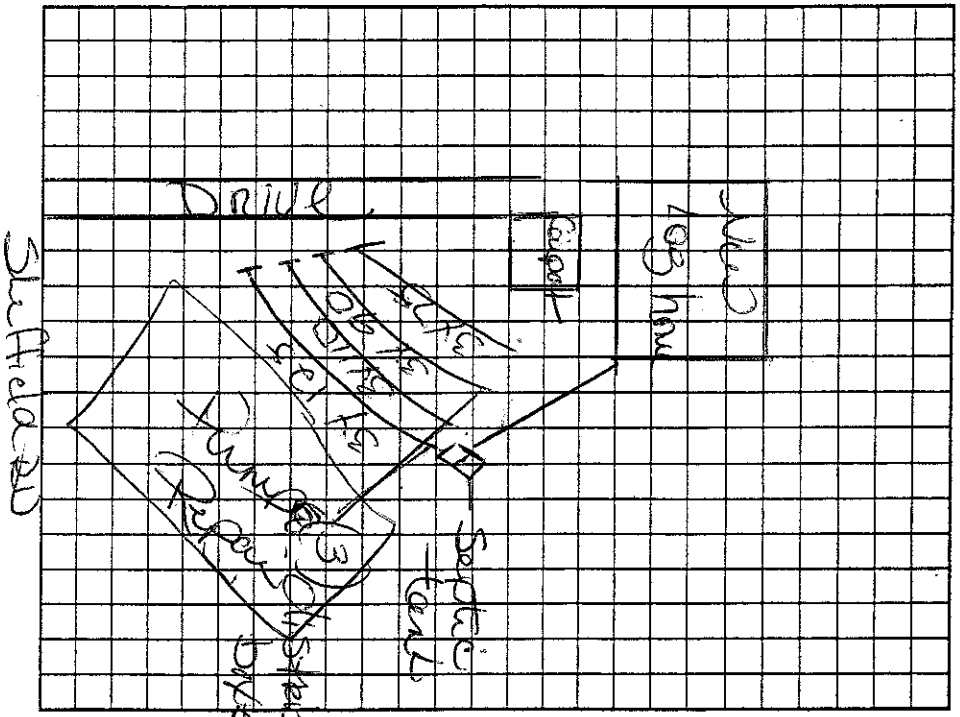

Permit can be suspended or revoked if any false information is supplied toward securing the permit/any unauthorized changes are made to the site/any unauthorized changes are made in the installation of the system. Improvement Permit with plat valid without expiration. ☐ Improvement Permit with site plan valid for sixty months ☐ Authorization to Construct is valid for a period equal to that of Improvement Permit – not to exceed sixty months.

Signed: date

Improvement Permit by: date

Authorization to Construct by: date

Installed by:

Operation Permit by: date

Existing System Inspection by: date 6-14-07

HEALTH DEPT. COPY: WHITE OWNER COPY (FINAL): YELLOW OWNER COPY (INITIAL): PINK