IREDELL COUNTY HEALTH DEPARTMENT

STATESVILLE 704-878-5305 MOORESVILLE 704-664-5281

IMPROVEMENT PERMIT / AUTHORIZATION TO CONSTRUCT / OPERATION PERMIT / EXISTING SYSTEM INSPECTION

PERMIT# 094539 PIN# 4891539820 DATE 1/20/01

OWNER OR CONTRACTOR Bobby Knight PHONE: Business — Home (704) 546-7297

ADDRESS 292 Rock Springs Rd Harmony, NC 28634

LOCATION Hwy 21 N, (1) Hwy 901, (2) Sheffield Rd, (3) Rock Springs Rd on Rt

SUBDIVISION — BLOCK / SECTION — LOT — LOT AREA — SITE CLASS. 5 DESIGN FLOW — L.T.A.R. —

Septic Tank: Existing 1000 Gallons; STB — Date —
Pump Tank: — Gallons; PT — Date —
Pump Make: — Model — Serial No. —
Nitrification Field: No Fields 1 Square Feet 750 Linear Feet 250'
No Lines 2@125 Trench Width — Max Trench Bottom Depth — Gravel Depth —

☐ New System ☐ Repair System Type: I, II, III, IV, V, VI
System Description: Existing 2BR
Repair System Description: —
Maintenance Agreement Required: ☐ Yes ☐ No

☐ House/Mod. Home No. Bedrooms 2
☒ Mobile Home No. Bathrooms 1
☐ Business No. Employees —
☐ Other —


☐ Slab ☐ Crawl Space ☐ Basement w/plumbing ☐ Basement wo/plumbing

Water Supply: ☒ Individual ☐ Public ☐ Community

Comments/Conditions: Existing System found as designed & permitted 9-6-79 (Bobby Knight). System appears to be OKay. wsf

Comments/Conditions:

INITIAL SITE SKETCH — Not to Scale

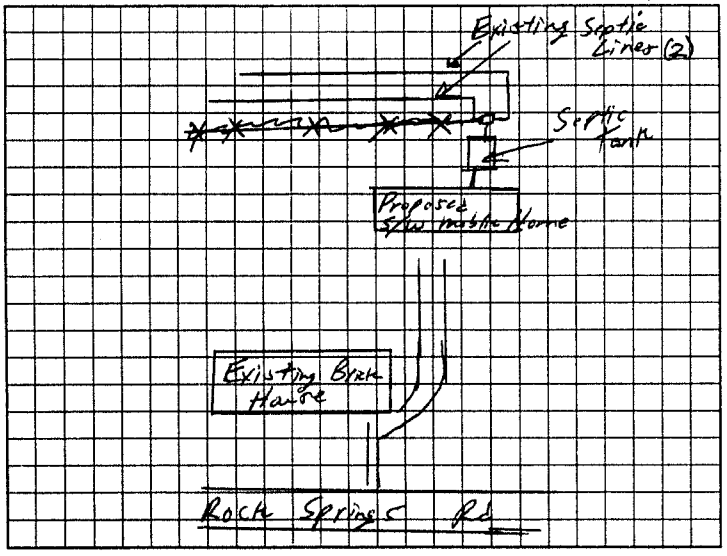

AS BUILT SKETCH

Permit can be suspended or revoked if any false information is supplied toward securing the permit/any unauthorized changes are made to the site/any unauthorized changes are made in the installation of the system. Improvement Permit with plat valid without expiration. Improvement Permit with site plan valid for sixty months. Authorization to Construct is valid for a period equal to that of Improvement Permit – not to exceed sixty months.

Signed: Bobby Knight date 1/24/01 Installed by: —

Improvement Permit by: — date — Operation Permit by: — date —

Authorization to Construct by: — date — Existing System Inspection by: William O. Johnson RSI date 1/20/01

HEALTH DEPT. COPY: WHITE OWNER COPY (FINAL): YELLOW OWNER COPY (INITIAL): PINK