IREDELL COUNTY HEALTH DEPARTMENT

STATESVILLE 704-878-5305 MOORESVILLE 704-664-5281

IMPROVEMENT PERMIT / AUTHORIZATION TO CONSTRUCT / OPERATION PERMIT / EXISTING SYSTEM INSPECTION

PERMIT# 083766 PIN# 4891 54 5111 DATE 9-30-99

OWNER OR CONTRACTOR TONY M. KNIGHT PHONE: Business Home 546-7297

ADDRESS 282 ROCK SPRINGS ROAD, HARMONY, NC 28634

LOCATION US 21 N, TL SHEFFIELD ROAD, TL ROCK SPRINGS ROAD, LOT ON LEFT ACROSS FROM BOX #282

SUBDIVISION SHAW BLOCK / SECTION LOT 23/24 LOT AREA ~3.6 ACRES SITE CLASS PS DESIGN FLOW 480 L.T.A.R. 0.33 GPD/FT²

Septic Tank: 1000 Gallons, STB 1012 Date 8-17-99
Pump Tank: Gallons, PT Date
Pump Make: Model Serial No
Nitrification Field: No Fields 1 Square Feet 1440 Linear Feet 480
No Lines FOUR Trench Width 36" Max Trench Bottom Depth 36" Gravel Depth 12"

✓ New System Repair System Type I (II) III IV V VI
System Description CONVENTIONAL GRAVITY
Repair System Description CONVENTIONAL PUMP
Maintenance Agreement Required Yes ✓ No


✓ House/Mod. Home No. Bedrooms 4
✓ Mobile Home T/W No. Bathrooms 2
Business No. Employees
Other
Slab ✓ Crawl Space Basement w/plumbing Basement wo/plumbing

Water Supply: ✓ Individual ☐ Public ☐ Community
WELL


Comments /Conditions ① KEEP SYSTEM MINIMUM 100 FEET FROM WELL ② INSTALL LINES ON CONTOUR AS SHOWN

Comments /Conditions SEPTIC TANK WITH MARKER INSTALLED USING "POLYLOK" FILTER

INITIAL SITE SKETCH

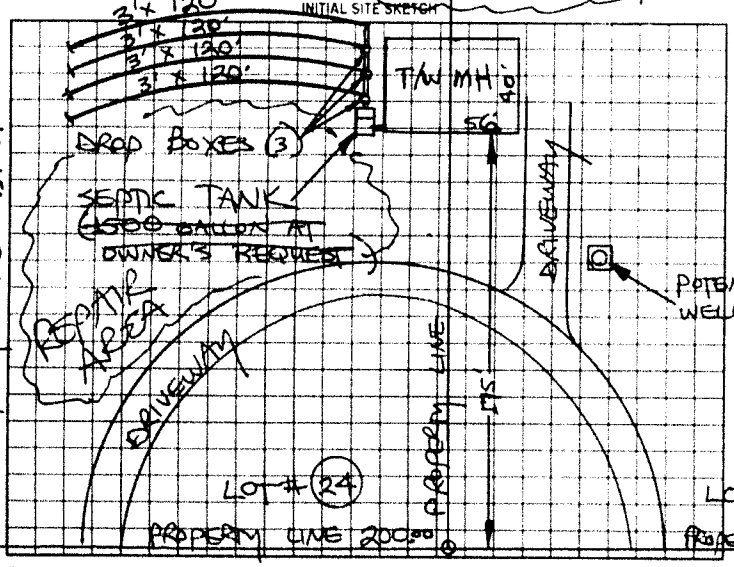

AS BUILT SKETCH

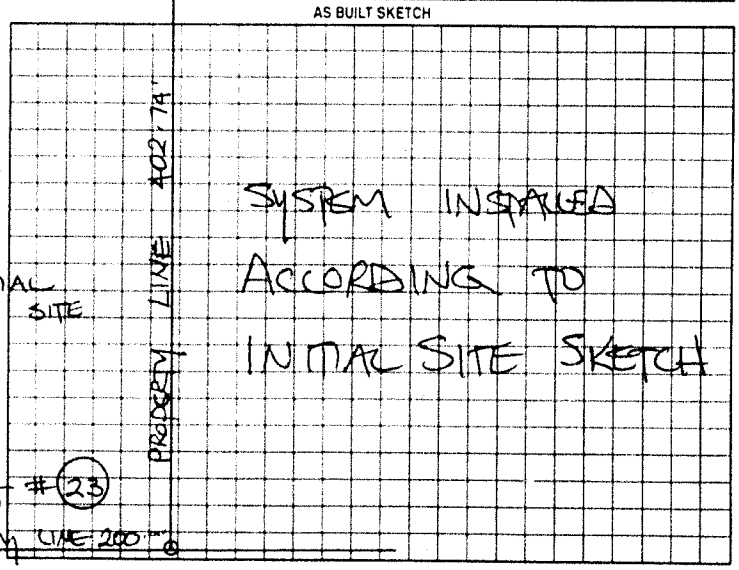

Permit can be suspended or revoked if any false information is supplied toward securing the permit, any unauthorized changes are made to the site, any unauthorized changes are made in the installation of the system. Improvement Permit with plat valid without expiration. Improvement Permit with site plan valid for sixty months. Authorization to Construct is valid for a period equal to that of Improvement Permit - not to exceed sixty months.

Signed: Bobby Knight date 9-30-99 Installed by A-1 BACKHOE

Improvement Permit by: STEVE HEDRICK date 9-30-99 Operation Permit by STEVE HEDRICK date 11-4-99

Authorization to Construct by: STEVE HEDRICK date 9-30-99 Existing System Inspection by date

HEALTH DEPT COPY: WHITE OWNER COPY (FINAL): YELLOW OWNER COPY (INITIAL): PINK