IREDELL COUNTY HEALTH DEPARTMENT

STATESVILLE 704-878-5305 MOORESVILLE 704-664-5281

IMPROVEMENT PERMIT / CERTIFICATE OF COMPLETION / OPERATION PERMIT / EXISTING SYSTEM INSPECTION

PROPERTY DESCRIPTION NO. 256883 066374 DATE 11-26-96 TAX MAP NO. 17B-1-A-3 Watershed ☐ Yes ☑ No

OWNER OR CONTRACTOR JOE GREGORY PHONE: Business Home 546-5639

ADDRESS 449 ROCK SPRINGS ROAD, HARMONY, NC 28681

LOCATION US 21 N, TR NC 901, TL SHEFFIELD RD, TL ROCK SPRINGS RD, ON LEFT ~500' BEFORE CHURCH.

SUBDIVISION R.T. SHAW BLOCK / SECTION LOT 3 LOT AREA 150' X 250' SITE CLASS. PS DESIGN FLOW 360 L.T.A.R. 0.35 GPD/FT²

Septic Tank: 1000 Gallons; STB 1007 Date 6-3-97

Pump Tank: Gallons; PT Date

Pump Make: Model Serial No.

Nitrification Field: No Fields 1 Square Feet 1035 Linear Feet 345

No Lines THREE Trench Width 36" Max Trench Bottom Depth 36" Gravel Depth 12

☑ New System ☐ Repair System Type: I, II, III, IV, V, VI

System Description: CONVENTIONAL GRAVITY

Repair System Description: CHAMBERED, PUMP

Maintenance Agreement Required: ☐ Yes ☑ No (Panel)

☑ House/Mod. Home No. Bedrooms 3

☐ Mobile Home No. Bathrooms 2

☐ Business No. Employees

☐ Other

☐ Slab ☐ Crawl Space ☑ Basement w/plumbing ☐ Basement wo/plumbing


Water Supply: ☑ Individual ☐ Community ☐ Public WELL

Comments: ① KEEP SYSTEM MINIMUM 10' FROM PROPERTY LINE, 100' FROM WELL ② INSTALL LINES ON CONTOUR, NO DEEPER THAN 36", 9' O.C.


Comments: Well sited in repair Area

SCALE: 1"=40'

INITIAL SITE SKETCH

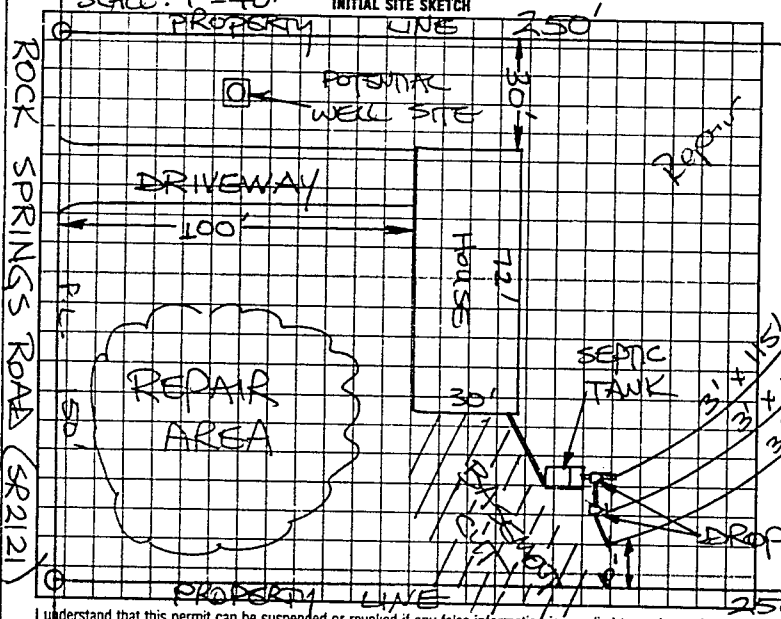

AS BUILT SKETCH

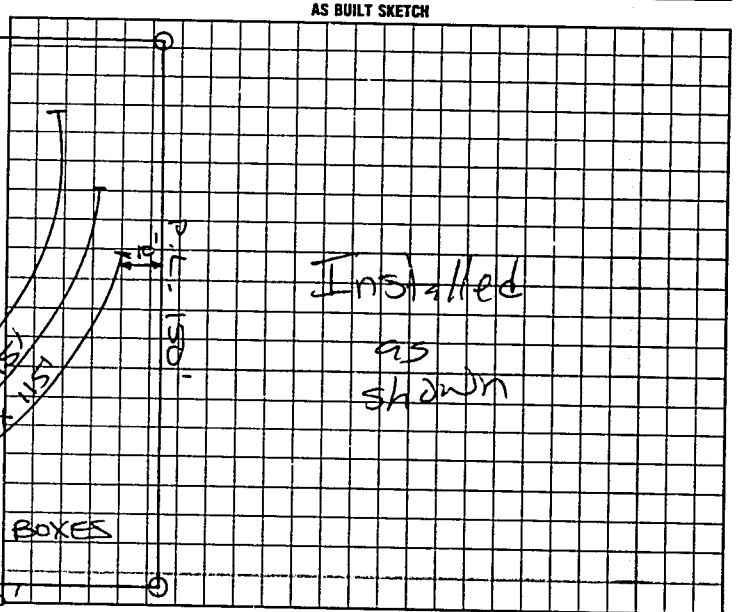

I understand that this permit can be suspended or revoked if any false information is supplied toward securing the permit/any unauthorized changes are made to the site/any unauthorized changes are made in the installation of the system. Improvement Permit is valid for 60 months from date of issuance. AUTH-TO CONST. IS VALID FOR A PERIOD EQUAL TO THE VALIDITY OF THE I.P. NOT TO EXCEED 5 YRS.

Signed: Kenneth McC

Improvement Permit by: STEVE HEDRICK date 11-26-96

AUTHORIZATION TO CONSTRUCT Existing system inspection by: STEVE HEDRICK date 11-26-96

Installed by: James Huddle

~~Certificate of Completion by:~~ date

Operation Permit by: Mary C. Outlaw RS date 7-15-97

HEALTH DEPT. COPY: WHITE INSPECTION COPY (FINAL): GREEN OWNER COPY (FINAL): YELLOW INSPECTION COPY (INITIAL): PINK OWNER COPY (INITIAL): GOLD