IREDELL COUNTY HEALTH DEPARTMENT

STATESVILLE 704-878-5305 (a) MOORESVILLE 704-664-5281

IMPROVEMENT PERMIT / AUTHORIZATION TO CONSTRUCT / OPERATION PERMIT / EXISTING SYSTEM INSPECTION

PERMIT # 15 16652 PIN # 4892 002671 DATE 5-29-09

OWNER or APPLICANT Donald Benton PHONE: Business Home: 704-746-4718

OWNER or APPLICANT ADDRESS 537 Abbydale Statesville NC

LOCATION / DIRECTIONS 21N (R) Pinnell Bridge (R) Rocky Road (R) Abbydale

SUBDIVISION BLOCK / SECTION LOT # LOT AREA 1.9 DESIGN FLOW 360 L.T.A.R. 0.98

Septic Tank EX 1SF Gallons: STB Date

Pump Tank Gallons: P T Date

Pump Make Model Serial #

Nitrification Field No Fields No Lines 2 Linear Feet 150' + 9@75'bd

Trench Width 36" Max. Trench Bottom Depth 36" Gravel Depth 0.98

☐ New System ☐ Repair ☑ Expansion System Type I II III IV V VI

System Description: 25% of 150' + 9@75' bd

Repair System Description:

Maintenance Agreement Required ☐ YES ☐ NO

☑ GRAVITY ☐ PRESSURE

☑ Residence No. Bedrooms 3

☐ Business No. Persons

☐ Other No. Employees


☐ Slab ☐ Crawl Space

☐ Basement w/plumbing ☐ Basement w/o plumbing

Water Supply: ☑ Private ☐ Public ☐ Community

Comments / Conditions


INITIAL SITE SKETCH

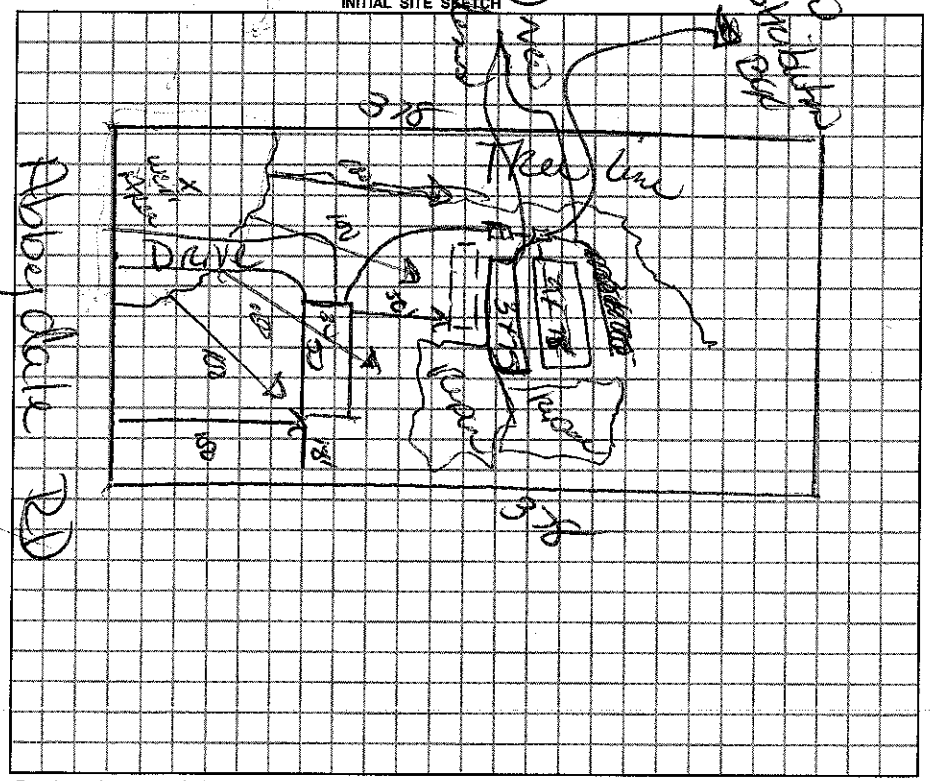

Comments / Conditions

Tank is in excellent shape appears to have never been full — Rock in bed system still clean

AS-BUILT SKETCH

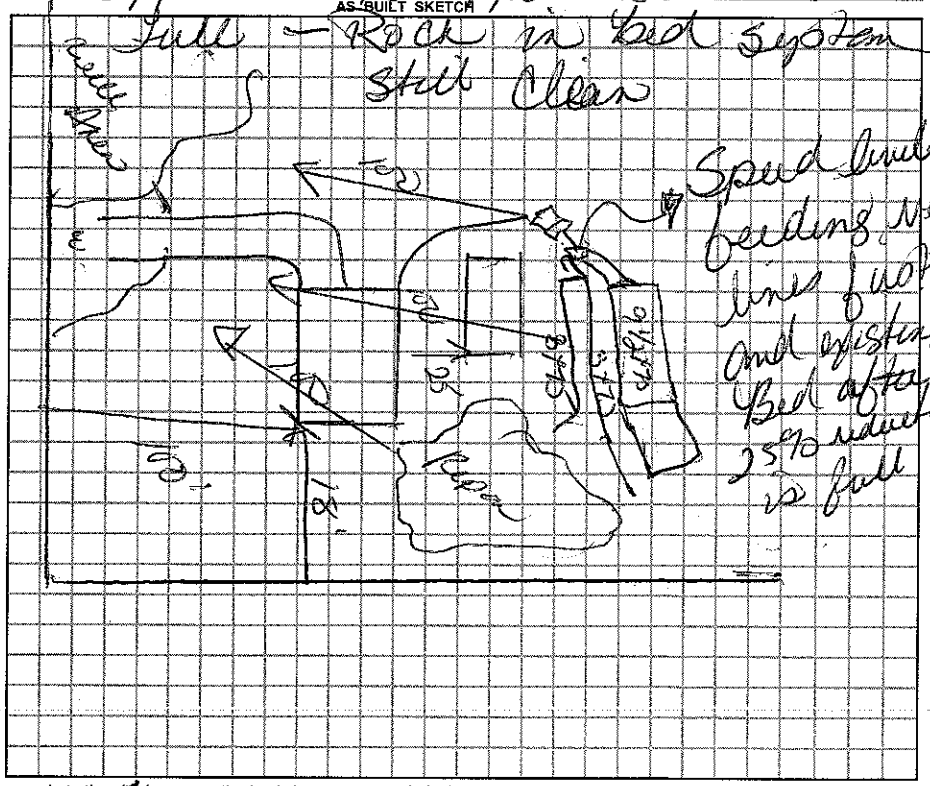

Spread onsite bedding, new lines & WP and existing bed after 25% reduction up fall

Permit can be suspended or revoked if any false information is supplied toward securing the permit / any unauthorized changes are made to the site / any unauthorized changes are made in the installation of the system.

☐ *IMPROVEMENT PERMIT w / plat valid without expiration.* ☐ *IMPROVEMENT PERMIT w / site plan valid for 60 mos.* ☑ *AUTHORIZATION TO CONSTRUCT valid for period equal to IMPROVEMENT PERMIT-not to exceed 60 mo.*

Owner / Applicant Signature: Donald Benton Date 5-29-09

Improvement Permit by: Date 5-29-09

Authorzation to Construct by: Date 5-29-09

YOU SHOULD CONTACT A LOCATOR SERVICE PRIOR TO ANY EXCAVATION.

Installed by: AJ Backhoe

Operation Permit by: Date: 6/3/2009

Existing System Inspected by: Date:

WHITE COPY Environmental Health YELLOW COPY (Final) Owner / Applicant PINK COPY (Initial) Owner / Applicant