IREDELL COUNTY HEALTH DEPARTMENT

Statesville Office (704) 878-5305 Mooresville Office (704) 660-3625 PERMIT # 181261

IMPROVEMENT PERMIT / AUTHORIZATION TO CONSTRUCT / OPERATION PERMIT / EXISTING SYSTEM

PIN # 4892024638

APPLICANT: TRICIA HORVATH APPLICANT ADDRESS: 695 ABBEYDALE CO HARMONY NC 28634

SITE ADDRESS: 665 ABBEYDALE RD HARMONY NC 28634 PHONE: ALT. PHONE:

SITE DIRECTIONS: 21N - TR POWELL BRIDGE RD - TL ROCKY FORD RD - TR ABBEYDALE - ON CT . 8 MILE

SUBDIVISION: SECTION: LOT # LOT AREA: ~15AC DESIGN FLOW: 360 L.T.A.R.: EXISTING

Septic Tank EXISTING (gal) STB Date

Pump Tank (gal) PT Date

Pump Make Model Serial #

Nitrification Fields 1 # Lines 3 Linear Ft: 300

Trench Width EXISTING Max. Trench Bottom Depth EXISTING Gravel Depth EXISTING

☐ New System ☐ Repair ☐ Expansion System Type: I (II) III IV V VI

System Description: GRAVITY CONVENTIONAL

Repair System Description: SAME

Maintenance Agreement Required: ☐ YES ☑ NO

☑ GRAVITY ☐ PRESSURE

☐ Residence No. Bedrooms 3

☐ Business No. Persons 6

☐ Other No. Employees

☐ Slab ☑ Crawl Space

☐ Basement w/plumbing ☐ Basement w/o plumbing

Water Supply

☑ Private


☐ Public

☐ Community

Comments / Conditions: SYSTEM FUNCTIONING PROPERLY AT TIME OF INSPECTION.

NOT TO SCALE

INITIAL SITE SKETCH

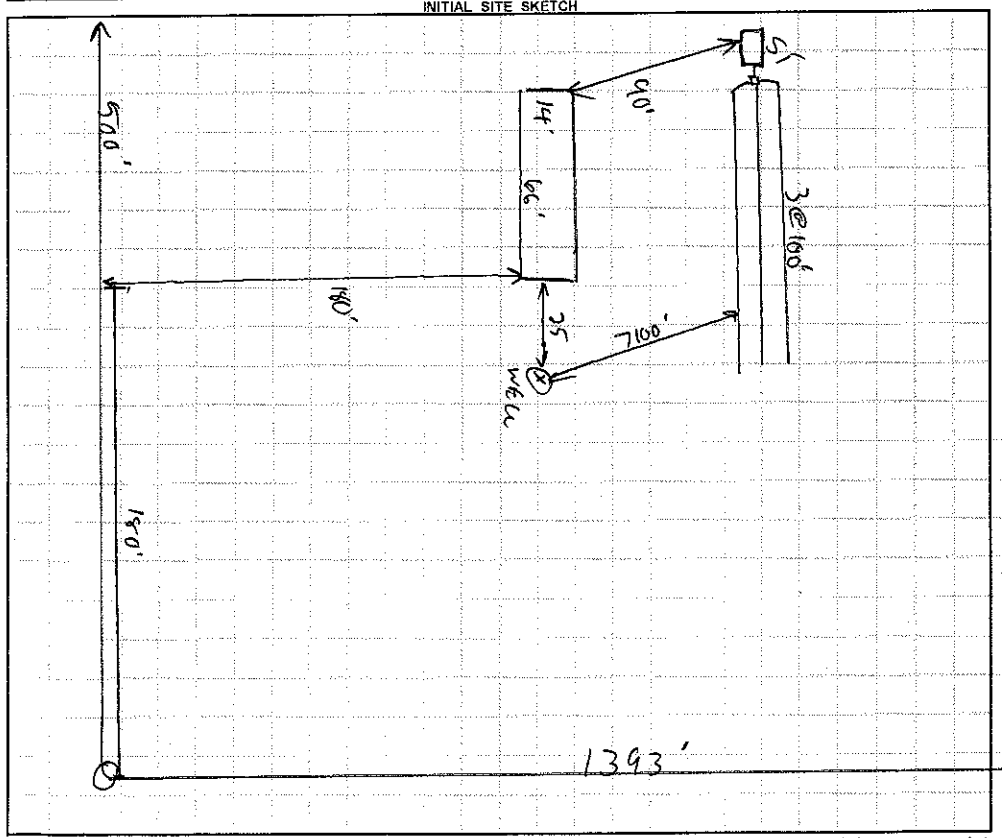

AS BUILT SKETCH

Permit can be suspended or revoked if any false information is supplied toward securing the permit / any unauthorized changes are made to the site / any unauthorized changes are made in the installation of the system. **CONTACT A LOCATOR SERVICE PRIOR TO ANY EXCAVATION**

☐ **IMPROVEMENT PERMIT** *with plat valid without expiration.* ☐ **IMPROVEMENT PERMIT** *with site plan valid for 60 mos.* ☐ **AUTHORIZATION TO CONSTRUCT** *valid for period equal to IMPROVEMENT PERMIT--not to exceed 60 mo.*

Owner / Applicant Signature: Tricia Horvath Date: 10-14-13 Installed by:

IMPROVEMENT PERMIT by: Date: OPERATION PERMIT by: Date:

AUTHORIZATION TO CONSTRUCT by: Date: Existing System Inspected by: C. [illegible] Date: 10/14/13

Health Dept. Copy - WHITE Applicant (Final Approval) - YELLOW Applicant (Conditional Approval) - PINK