IREDELL COUNTY HEALTH DEPARTMENT

STATESVILLE 704-878-5305 (L) MOORESVILLE 704-664-5281

IMPROVEMENT PERMIT / AUTHORIZATION TO CONSTRUCT / OPERATION PERMIT / EXISTING SYSTEM INSPECTION

(L)

PERMIT# 109376 PIN# 4892-12-4529 2476 DATE 10-30-02

OWNER OR ~~CONTRACTOR~~ JAMES DYE PHONE: Business Home (704)-873-4989

ADDRESS 386 GARDEN VALLEY ROAD STATESVILLE, NC 28625

LOCATION US 21 N, TR POWELL BRIDGE RD, TL ROCKY FORD ROAD, TR ABBEYDALE ROAD, 0.9 MILE ON RIGHT

SUBDIVISION BLOCK / SECTION LOT LOT AREA 3.85 ACRES SITE CLASS PS DESIGN FLOW 240 L.T.A.R. 0.30 GPD/FT²

Septic Tank: 1000 Gallons; STB 760 Date 5-4-02
Pump Tank: Gallons; PT Date
Pump Make: Model Serial No.
Nitrification Field: No Fields 1 Square Feet 810 Linear Feet 270
No Lines THREE Trench Width 36" Max Trench Bottom Depth 36" Gravel Depth 12"

☒ New System ☐ Repair System Type: I (II) III IV V VI
System Description: CONVENTIONAL GRAVITY
Repair System Description: CONVENTIONAL GRAVITY
Maintenance Agreement Required: ☐ Yes ☒ No


☐ House/Mod. Home No. Bedrooms 2
☒ Mobile Home No. Bathrooms 2
☐ Business No. Employees
☐ Other
☐ Slab ☑ Crawl Space ☐ Basement w/plumbing ☐ Basement wo/plumbing

Water Supply: ☒ Individual ☐ Public ☐ Community
WELL

Comments:/Conditions: KEEP SYSTEM MINIMUM 100 FEET FROM WELL

Comments:/Conditions: SEPTIC TANK WITH RISERS INSTALLED USING "ZABEL" FILTER

INITIAL SITE SKETCH

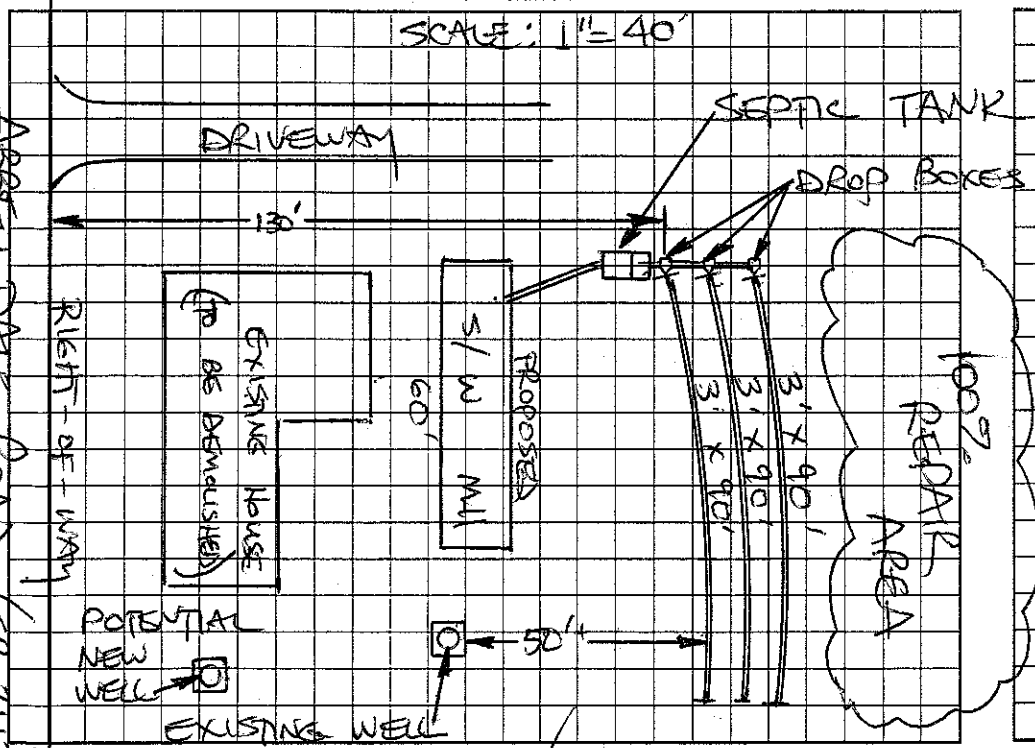

AS BUILT SKETCH

SYSTEM INSTALLED ACCORDING TO INITAL SITE SKETCH

Permit can be suspended or revoked if any false information is supplied toward securing the permit/any unauthorized changes are made to the site/any unauthorized changes are made in the installation of the system. Improvement Permit with plat valid without expiration. Improvement Permit with site plan valid for sixty months. Authorization to Construct is valid for a period equal to that of Improvement Permit -- not to exceed sixty months.

Signed: [signature] date 10/30/02 Installed by: BRENT GALLIHER

Improvement Permit by: STEVE HEDRICK date 10/30/02 Operation Permit by: STEVE HEDRICK date 1-8-03

Authorization to Construct by: STEVE HEDRICK date 10-30-02 Existing System Inspection by: date

HEALTH DEPT. COPY: WHITE OWNER COPY (FINAL): YELLOW OWNER COPY (INITIAL): PINK