IREDELL COUNTY HEALTH DEPARTMENT

STATESVILLE 704-878-5305 MOORESVILLE 704-664-5281

IMPROVEMENT PERMIT / AUTHORIZATION TO CONSTRUCT / OPERATION PERMIT / EXISTING SYSTEM INSPECTION

PERMIT# 088 233 PIN# 4892 - ~~04 9248 (PT)~~ 14-1018 DATE 4-3-00

OWNER OR CONTRACTOR LORI REAVIS PHONE: Business Home 546-2169

ADDRESS 745 ABBEYDALE ROAD, HARMONY, NC 28634

LOCATION US21N, TR POWELL, TL ROCKY FORD, TR ABBEYDALE ROAD, ≈1.0 MILE ON LEFT

SUBDIVISION BLOCK / SECTION LOT LOT AREA 1.701 ACRES SITE CLASS. PS DESIGN FLOW 360 L.T.A.R. 0.25 GPD/FT²

Septic Tank: 1000 Gallons; STB 1020 Date 11-14-02
Pump Tank: Gallons; PT Date
Pump Make: Model Serial No.
Nitrification Field: No Fields 1 Square Feet 1440 Linear Feet 480
No Lines SIX Trench Width 36" Max Trench Bottom Depth 30" Gravel Depth 12"

☑ New System ☐ Repair System Type: I, II, III, IV, V, VI
System Description: CONVENTIONAL GRAVITY
Repair System Description: CONV. GRAVITY
Maintenance Agreement Required: ☐ Yes ☑ No


☐ House/Mod. Home No. Bedrooms 3
☑ Mobile Home No. Bathrooms 2
☐ Business No. Employees
☐ Other
☐ Slab ☑ Crawl Space ☐ Basement w/plumbing ☐ Basement wo/plumbing

Water Supply: ☑ Individual ☐ Public ☐ Community
WELL NEXT TO DOOR


Comments:/Conditions: INSTALL SUBSURFACE INTERCEPT DRAINAGE DITCH AT LOCATION SHOWN BEGINNING 42 INCHES DEEP OUT TO DAYLIGHT

Comments:/Conditions: ① SEPTIC TANK W/ RISERS INSTALLED USING "ZABEL" FILTER ② SYSTEM LEFT OPEN DURING PERIOD OF WET WEATHER

INITIAL SITE SKETCH

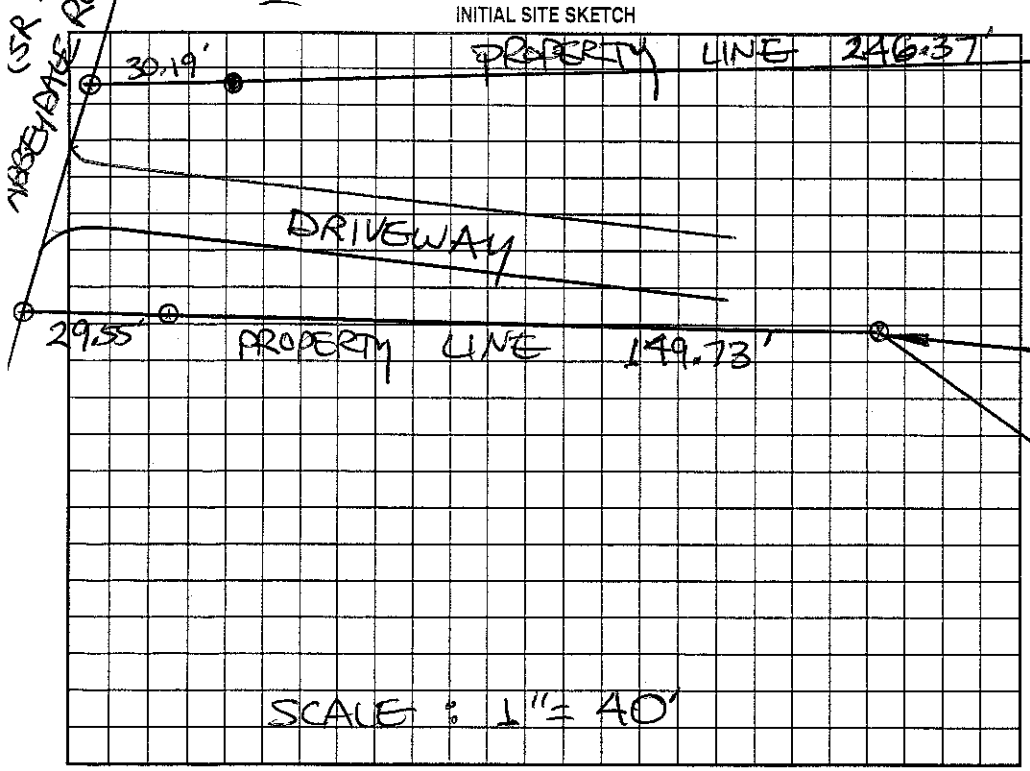

AS BUILT SKETCH

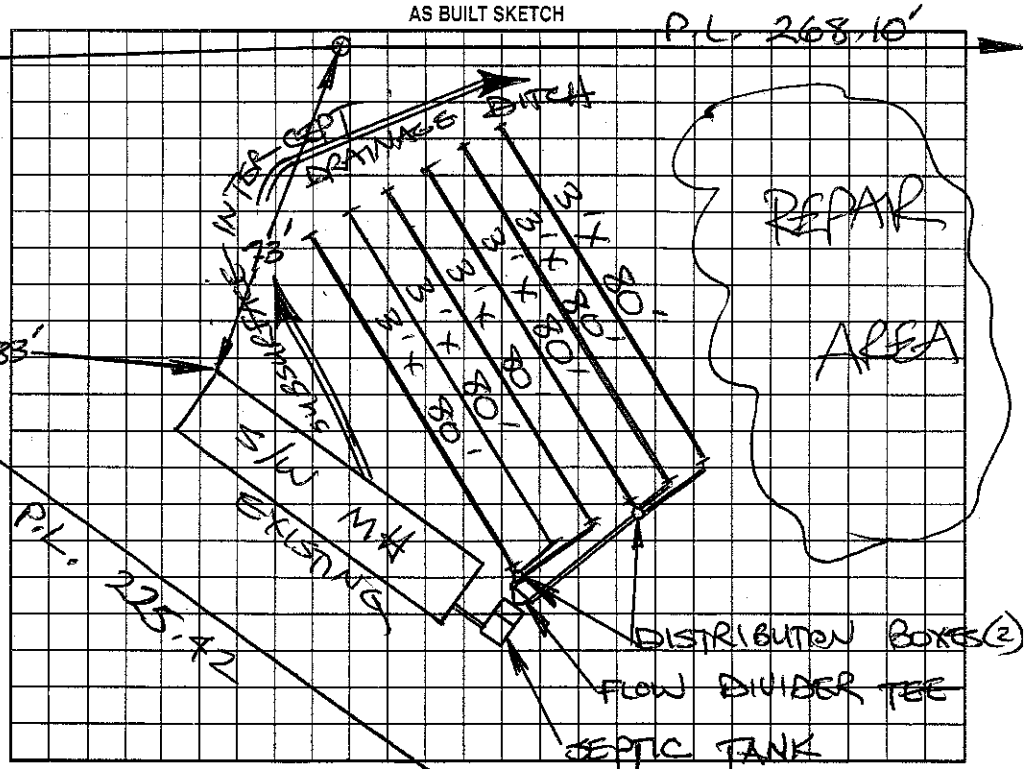

Permit can be suspended or revoked if any false information is supplied toward securing the permit/any unauthorized changes are made to the site/any unauthorized changes are made in the installation of the system. Improvement Permit with plat valid without expiration, Improvement Permit with site plan valid for sixty months. Authorization to Construct is valid for a period equal to that of Improvement Permit – not to exceed sixty months.

Signed: Robert Reavis date 4-4-00 Installed by: SAMMY REAVIS

Improvement Permit by: STEVE HEDRICK date 4-3-00 Operation Permit by: STEVE HEDRICK date 4-1-03

Authorization to Construct by: STEVE HEDRICK date 4-3-00 Existing System Inspection by: date

HEALTH DEPT. COPY: WHITE OWNER COPY (FINAL): YELLOW OWNER COPY (INITIAL): PINK