IREDELL COUNTY HEALTH DEPARTMENT

STATESVILLE 704-878-5305 MOORESVILLE 704-664-5281

IMPROVEMENT PERMIT / AUTHORIZATION TO CONSTRUCT / OPERATION PERMIT / EXISTING SYSTEM INSPECTION

PERMIT# 143516 PIN# 4892147458.018 DATE 28 June 07

OWNER OR APPLICANT Frederick & Lori Dalton PHONE: Business ______ Home 704 546-5-0734

ADDRESS 137 Abbeydale RD Harmony NC 28634

LOCATION 21W Powell (L) Rocky Ford (R) Abbeydale 1 mile on right

SUBDIVISION ______ BLOCK / SECTION ______ LOT ______ LOT AREA 1.7 SITE CLASS. B DESIGN FLOW 360 L.T.A.R. .25

Septic Tank: 1000 Gallons; STB 620 Date 11-14-02

Pump Tank: ______ Gallons; PT ______ Date ______

Pump Make: ______ Model ______ Serial No. ______

Nitrification Field: No Fields 1 Square Feet 1440 Linear Feet 480

No Lines 6 Trench Width 36" Max Trench Bottom Depth 30 Gravel Depth 12" ☐ Gravity ☐ Pressure

☐ New System ☐ Repair ☐ Expansion System Type: I II III IV V VI

System Description: ______

Repair System Description: Exist - Gravity

Maintenance Agreement Required: ☐ Yes ☐ No

☑ House/Mod. Home ☐ Mobile Home ☐ Business ☐ Other ______

No. Bedrooms 3 No. Persons 2 No. Employees ______


Water Supply: ☑ Individual ☐ Public ☐ Community

☐ Slab ☐ Crawl Space ☐ Basement w/plumbing ☐ Basement wo/plumbing


Comments:/Conditions:

Comments:/Conditions:

INITIAL SITE SKETCH

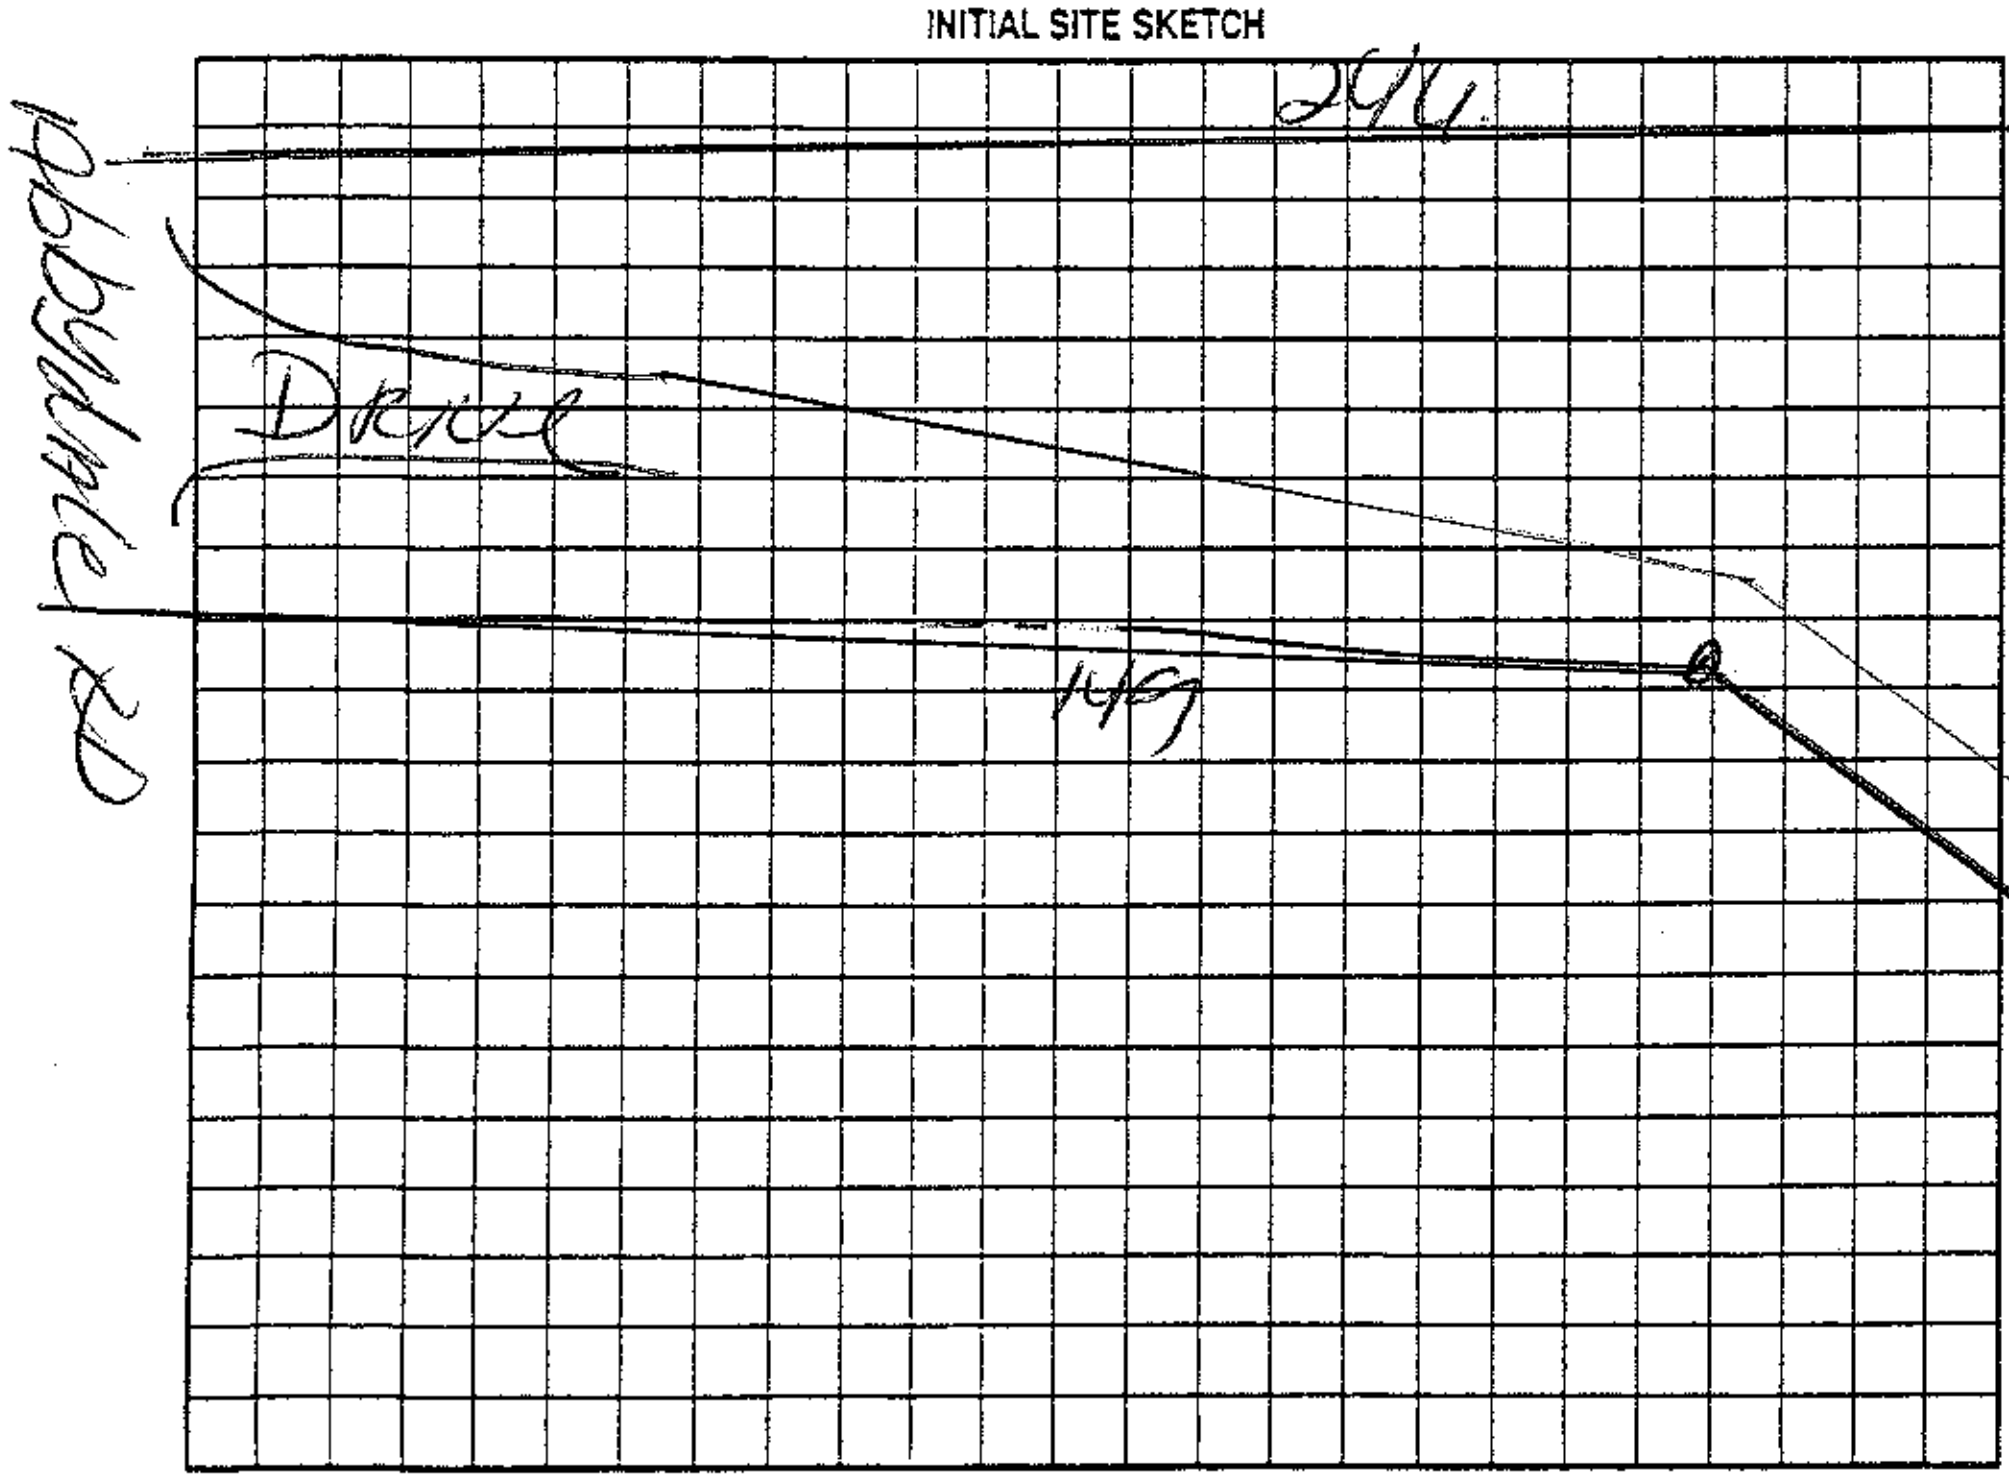

AS BUILT SKETCH

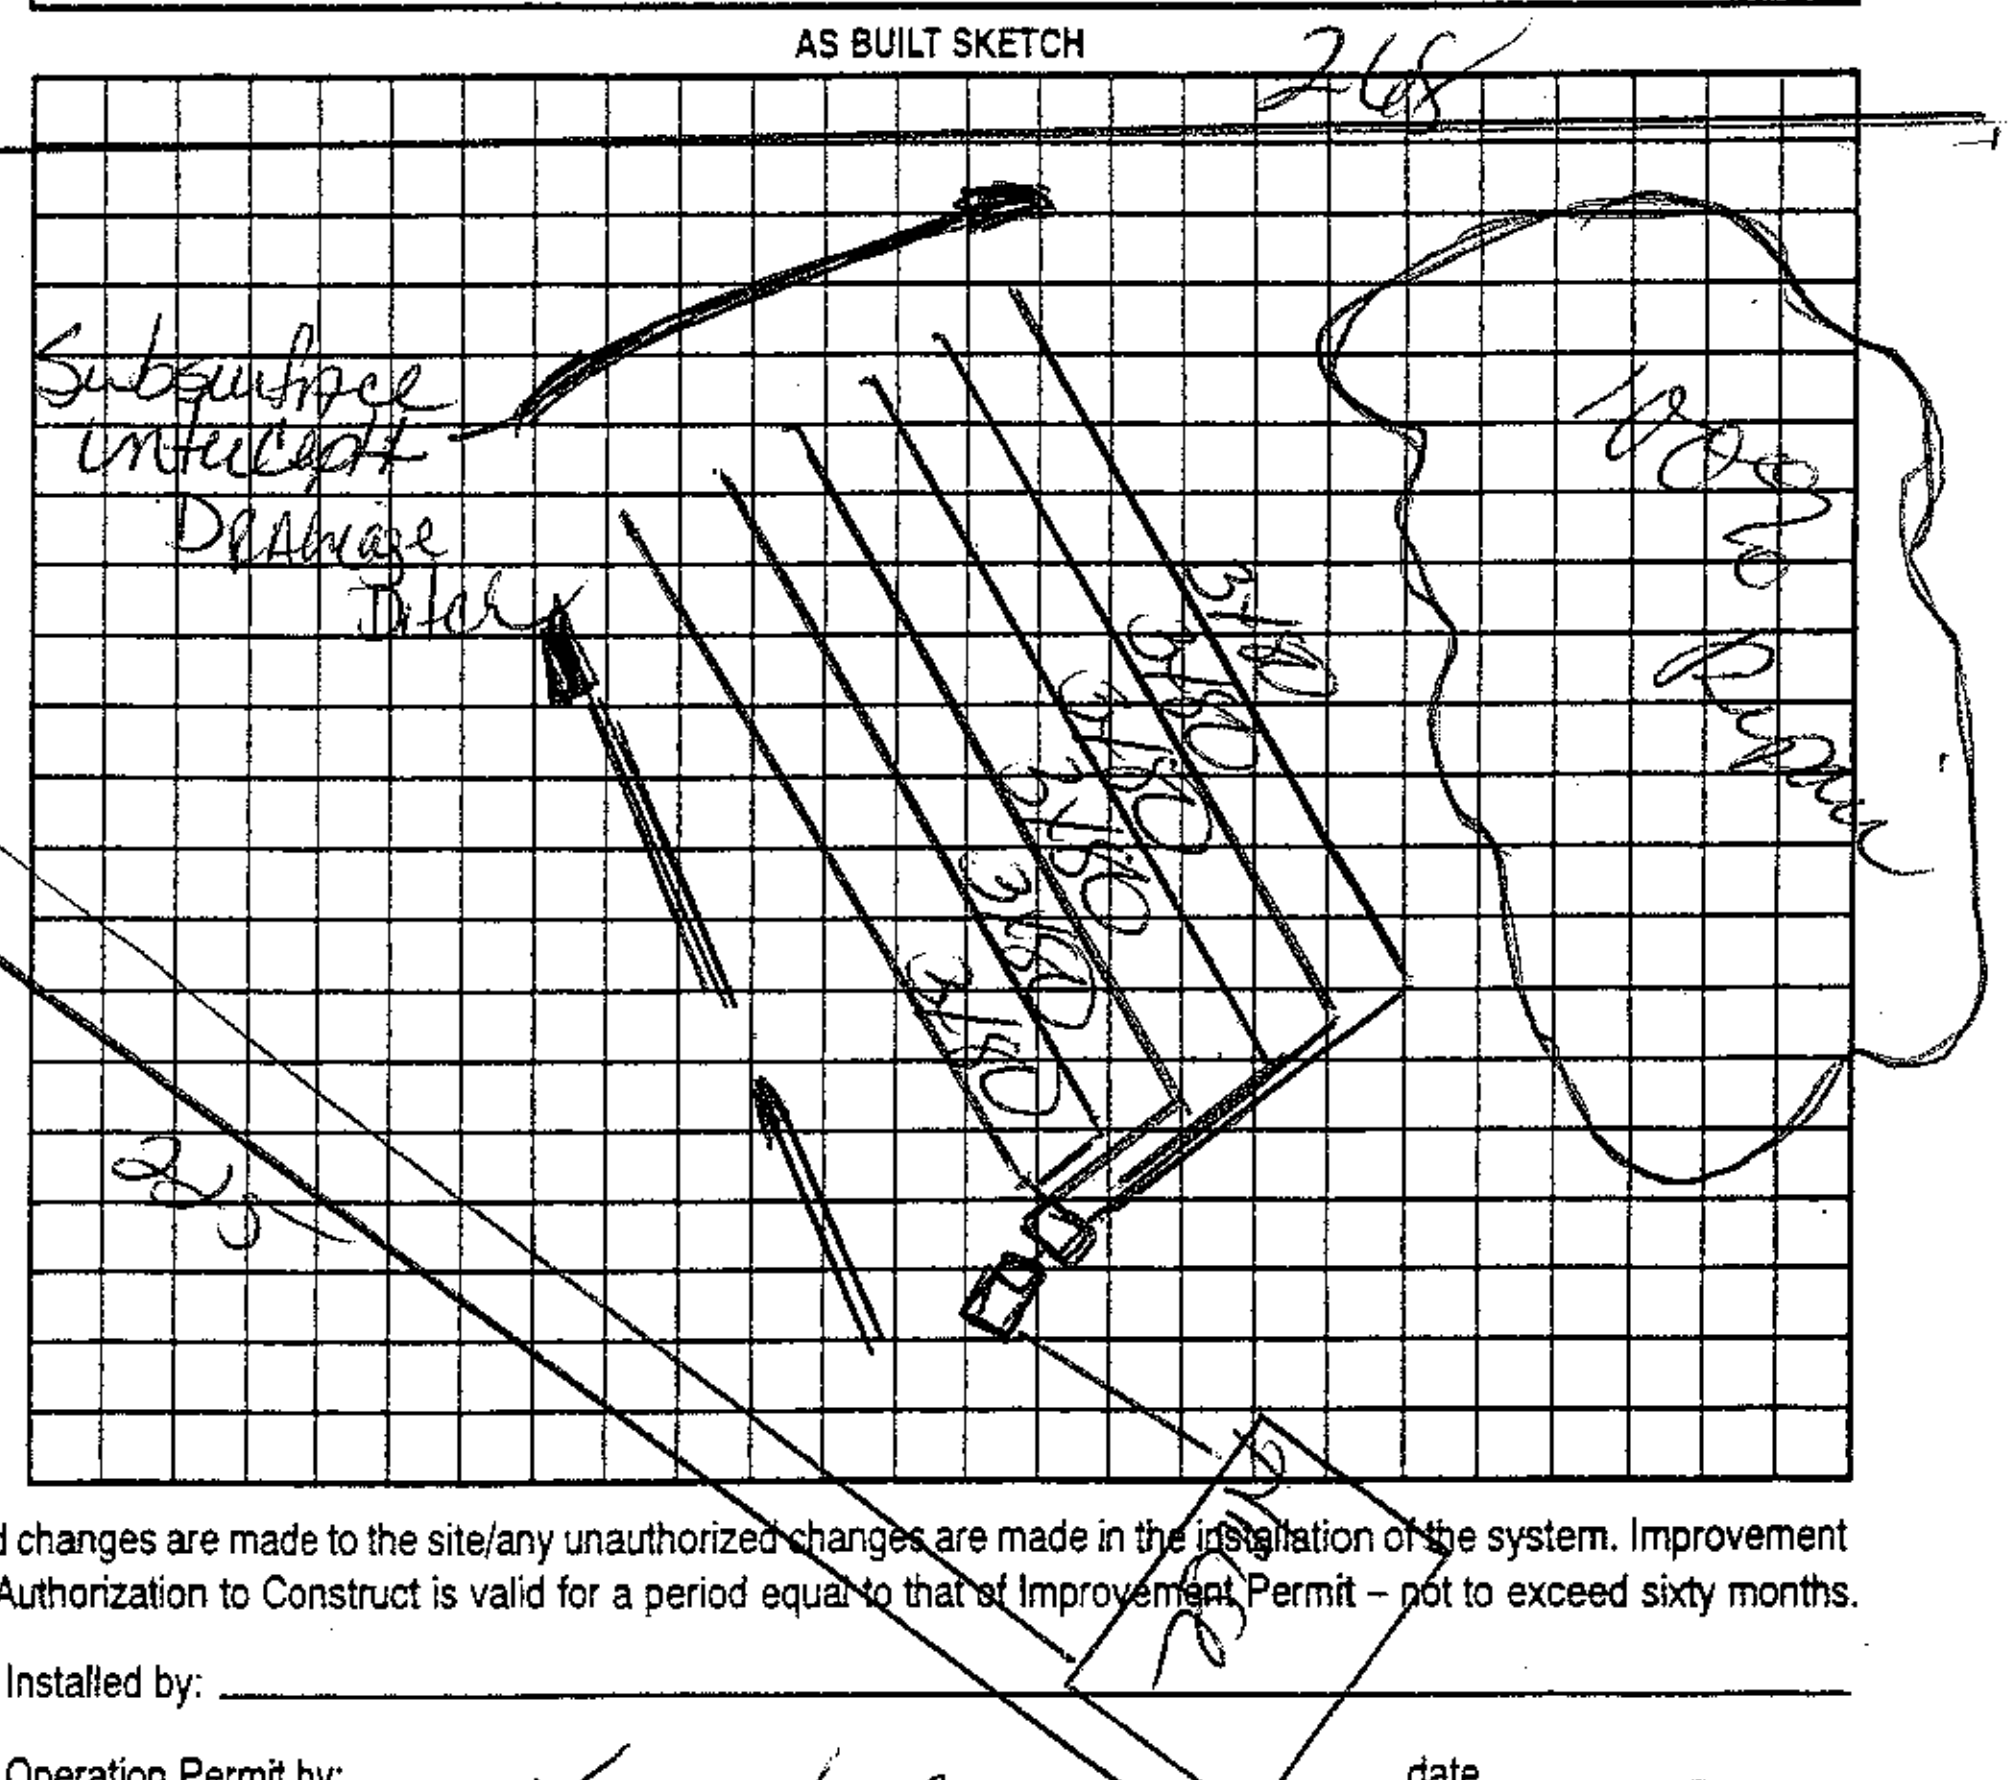

Permit can be suspended or revoked if any false information is supplied toward securing the permit/any unauthorized changes are made to the site/any unauthorized changes are made in the installation of the system. Improvement Permit with plat valid without expiration ☐ Improvement Permit with site plan valid for sixty months ☐ Authorization to Construct is valid for a period equal to that of Improvement Permit – not to exceed sixty months.

Signed: Lori R. Dalton date 6/28/07 Installed by: ______

Improvement Permit by: ______ date ______ Operation Permit by: ______ date ______

Authorization to Construct by: ______ date ______ Existing System Inspection by: [signature] date 28 June 07

HEALTH DEPT. COPY: WHITE OWNER COPY (FINAL): YELLOW OWNER COPY (INITIAL): PINK