IREDELL COUNTY HEALTH DEPARTMENT

STATESVILLE 704-878-5305 (a) MOORESVILLE 704-664-5281

IMPROVEMENT PERMIT / AUTHORIZATION TO CONSTRUCT / OPERATION PERMIT / EXISTING SYSTEM INSPECTION

PERMIT# 30686 PIN# 4892222527 DATE 9-6-05

OWNER OR CONTRACTOR Brian & Loretta Drink Water PHONE: Business _____ Home 352-821-0407

ADDRESS Box 83 Wesley Dale FL 32195

LOCATION 21 N - TC Powell Bridge - TC Turkey Foot TO Sandy Spring 1st Left After Store (Abbeydale RD)

SUBDIVISION _____ BLOCK / SECTION _____ LOT _____ LOT AREA 11+ AC SITE CLASS 1 DESIGN FLOW 360 L.T.A.R. .3

Septic Tank: 1000 Gallons; STB 760 Date 1-2006
Pump Tank: _____ Gallons; PT _____ Date _____
Pump Make: _____ Model _____ Serial No. _____
Nitrification Field: No Fields 1 Square Feet 200 Linear Feet 300
No Lines 6 Trench Width 36" Max Trench Bottom Depth 36" Gravel Depth N/A


☑ New System ☐ Repair System Type: I, II, III, IV, V, VI
System Description: 25% - GRAVITY
Repair System Description: 25% Pump - PRV
Maintenance Agreement Required: ☐ Yes ☑ No

☑ House/Mod. Home No. Bedrooms 3
☐ Mobile Home No. Bathrooms ____
☐ Business No. Employees ____
☐ Other _____
☐ Slab ☐ Crawl Space ☐ Basement w/plumbing ☐ Basement wo/plumbing

Water Supply: ☑ Individual ☐ Public ☐ Community

Comments:/Conditions: NOT TO SCALE
Abbeydale RD
480'
300'


INITIAL SITE SKETCH

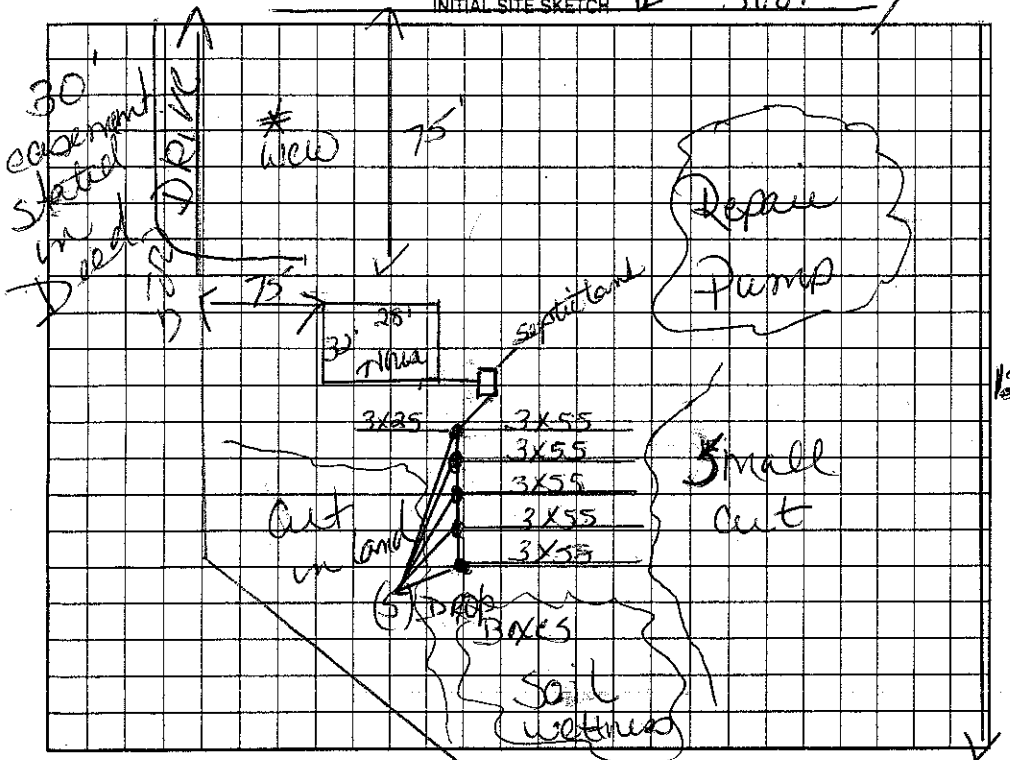

Comments:/Conditions: Abbeydale 8/10 mile on left
Install on contour - maintain setbacks
Keep system out of soil wetness area

AS BUILT SKETCH

SYSTEM ALTERED AS SHOWN WITH PRIOR HEALTH DEPT. APPROVAL. SEPTIC TANK WITH MARKER INSTALLED USING RED "Polylok" FILTER

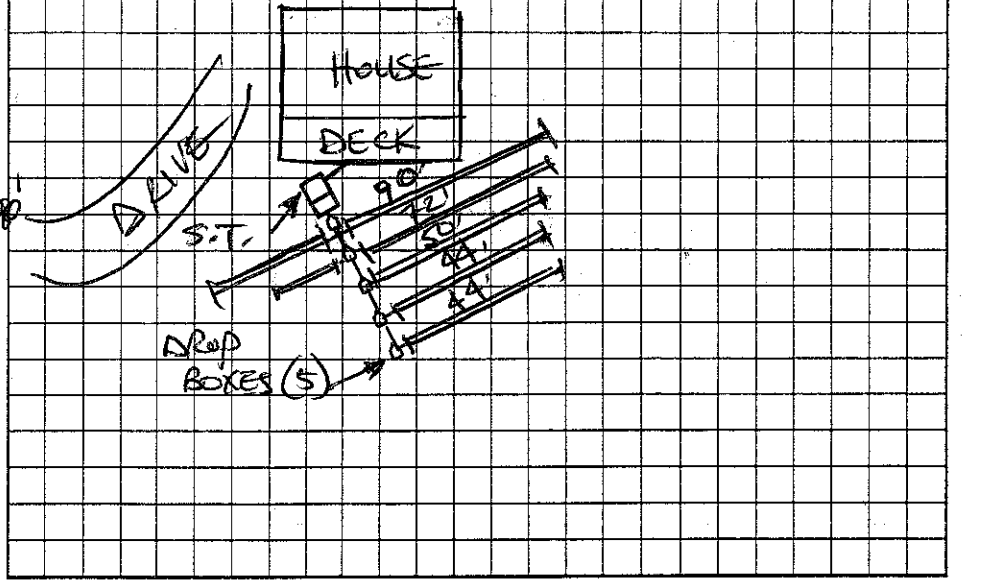

Permit can be suspended or revoked if any false information is supplied toward securing the permit/any unauthorized changes are made to the site/any unauthorized changes are made in the installation of the system. Improvement Permit with plat valid without expiration. Improvement Permit with site plan valid for sixty months. Authorization to Construct is valid for a period equal to that of Improvement Permit – not to exceed sixty months.

Signed: Wendy Blum date 9-30-05
Improvement Permit by: [signature] date 9-8-05
Authorization to Construct by: [signature] date 10-14-05

Installed by: RANDY MILLER
Operation Permit by: STEVE HEDRICK date 5-22-06
Existing System Inspection by: _____ date _____

HEALTH DEPT. COPY: WHITE OWNER COPY (FINAL): YELLOW OWNER COPY (INITIAL): PINK