IREDELL COUNTY HEALTH DEPARTMENT

STATESVILLE 704-878-5305 MOORESVILLE 704-664-5281

IMPROVEMENT PERMIT / AUTHORIZATION TO CONSTRUCT / OPERATION PERMIT / EXISTING SYSTEM INSPECTION

PERMIT# 131631 PIN# 4892 24 6613 DATE 10/14/05

OWNER OR CONTRACTOR Anthony Wilson PHONE: Business _____ Home 704 546 5179

ADDRESS 840 Sheffield Rd Harmony, NC 28634

LOCATION 21N @ Powell Bridge @ Rocky Ford @ Abbeydale Last drive on R 794 Abbeydale Rd

SUBDIVISION NA BLOCK / SECTION _____ LOT _____ LOT AREA 2.4 Acres SITE CLASS. PS DESIGN FLOW 360 L.T.A.R. .4

Septic Tank: Existing Gallons: STB _____ Date _____

Pump Tank: _____ Gallons: PT _____ Date _____

Pump Make: _____ Model _____ Serial No. _____

Nitrification Field: No Fields 1 Square Feet Exist + 240 Linear Feet Exist + 80

No Lines 3 Trench Width Exist, 36" Max Trench Bottom Depth Exist, 30" Gravel Depth Exist, 12"

☐ New System ☐ Repair System Type: I (II) III, IV, V, VI

System Description: Gravity conventional

Repair System Description: same

Maintenance Agreement Required: ☐ Yes ☒ No

☐ House/Mod. Home No. Bedrooms 3

☒ Mobile Home No. Bathrooms ____

☐ Business No. Employees ____

☐ Other _____

☐ Slab ☒ Crawl Space ☐ Basement w/plumbing ☐ Basement wo/plumbing


Water Supply: ☒ Individual ☐ Public ☐ Community

Comments:/Conditions:

Comments:/Conditions:

INITIAL SITE SKETCH

AS BUILT SKETCH

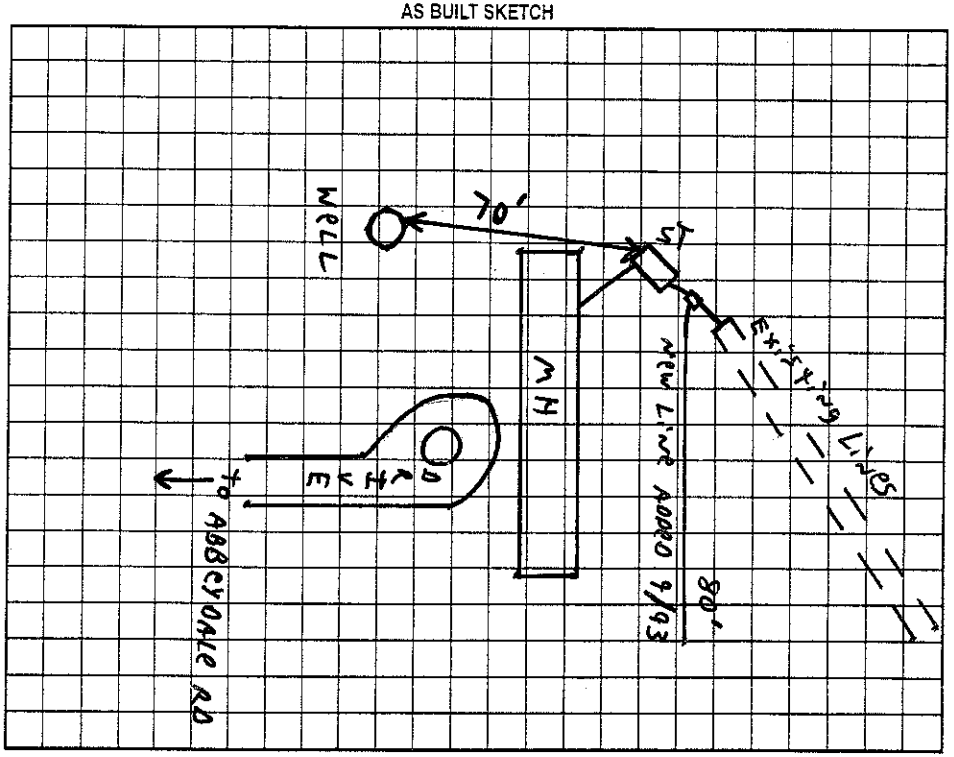

Permit can be suspended or revoked if any false information is supplied toward securing the permit/any unauthorized changes are made to the site/any unauthorized changes are made in the installation of the system. Improvement Permit with plat valid without expiration. Improvement Permit with site plan valid for sixty months. Authorization to Construct is valid for a period equal to that of Improvement Permit – not to exceed sixty months.

Signed: Anthony Wilson date 10-18-05 Installed by: _____

Improvement Permit by: _____ date _____ Operation Permit by: _____ date _____

Authorization to Construct by: _____ date _____ Existing System Inspection by: [signature] date 10/14/05

HEALTH DEPT. COPY: WHITE OWNER COPY (FINAL): YELLOW OWNER COPY (INITIAL): PINK