IREDELL COUNTY HEALTH DEPARTMENT

STATESVILLE 704-878-5305 MOORESVILLE 704-664-5281

IMPROVEMENT PERMIT / CERTIFICATE OF COMPLETION / OPERATION PERMIT / EXISTING SYSTEM INSPECTION

PROPERTY DESCRIPTION NO. 16296 DATE 9/30/93 TAX MAP NO. 17H-A-25

OWNER OR CONTRACTOR RICKY HIGGINS PHONE: Business 546-2602 Home 546-5210

ADDRESS RT. 2 BOX 242-A, HARMONY, NC 28634

LOCATION US 21N, TR POWELL BRIDGE, TL ROCKY FORD, TR ABBEYDALE, LAST DRIVE ON (R)

SUBDIVISION _____ BLOCK / SECTION _____ LOT _____ LOT AREA AMPLE SITE CLASS. PS L.T.A.R. 0.4

Water Supply: ☑ Individual ☐ Community ☐ Public WELL

Septic Tank: EXISTING Gallons: STB _____ Date _____

Pump Tank: _____ Gallons: PT _____ Date _____

Nitrification Field: No Fields _____ Square Feet 240 Linear Feet 80

No Lines 1 Trench Width 36" Trench Depth 30 Gravel Depth 12"

☐ New System ☑ Repair System Type: I (II) III, IV, V, VI

System Description: CONV, GRAVITY

Repair System Description: _____

Maintenance Agreement Required: ☐ Yes ☑ No

☐ House/Mod. Home ☑ Mobile Home ☐ Business ☐ Other _____

No. Bedrooms 3 No. Bathrooms 2 No. Employees _____

Garbage Disposal: ☐ Yes ☑ No

Auto. Dishwasher: ☑ Yes ☐ No


Auto. Washing Machine: ☑ Yes ☐ No

Other _____


☐ Slab ☑ Crawl Space ☐ Basement w/plumbing ☐ Basement wo/plumbing

Comments ① SEPTIC TANK WAS PUMPED-OUT ② NEW D. BOX INSTALLED AS SHOWN

INITIAL SITE SKETCH

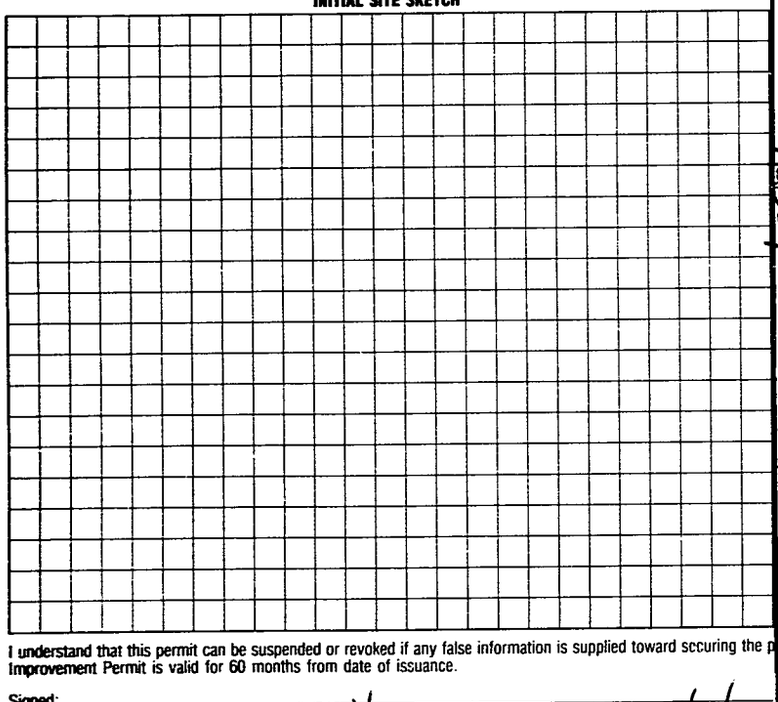

AS BUILT SKETCH

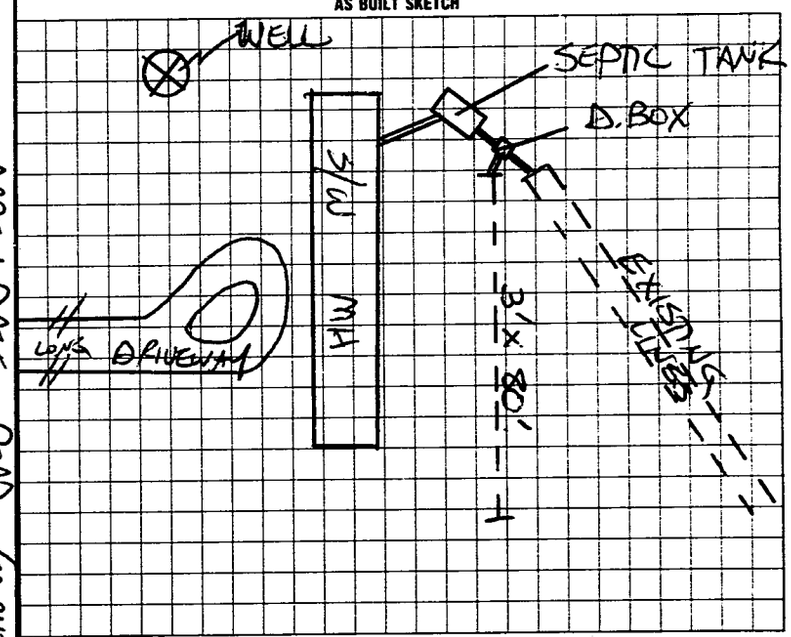

I understand that this permit can be suspended or revoked if any false information is supplied toward securing the permit/any unauthorized changes are made to the site/any unauthorized changes are made in the installation of the system. Improvement Permit is valid for 60 months from date of issuance.

Signed: _____

Improvement Permit by: STEVE HEDRICK date 5/4/93

Existing System Inspection by: _____ date _____

Installed by: SAMMY REAVIS

Certificate of Completion by: STEVE HEDRICK date 9/30/93

Operation Permit by: _____ date _____

HEALTH DEPT. COPY: WHITE INSPECTION COPY (FINAL): GREEN OWNER COPY (FINAL): YELLOW INSPECTION COPY (INITIAL): PINK OWNER COPY (INITIAL): GOLD