4892266902, ~~2310~~ 2328

IREDELL COUNTY HEALTH DEPARTMENT

STATESVILLE 704-878-5305 MOORESVILLE 704-664-5281

IMPROVEMENT PERMIT / CERTIFICATE OF COMPLETION / OPERATION PERMIT / EXISTING SYSTEM INSPECTION

PROPERTY DESCRIPTION NO. 50364 DATE 2/21/94 TAX MAP NO. 17H - A - 52 Watershed: ☐ Yes ☑ No

OWNER OR CONTRACTOR STEVE GUNTER PHONE: Business 546-7670 Home

ADDRESS RT 6, BOX 194 MOCKSVILLE NC 27028

LOCATION US 21 N, TR HOUSTONVILLE RD, TR SANDY SPRINGS RD, ON (L) PAST DOBY RD

SUBDIVISION BLOCK / SECTION LOT LOT AREA LIMITED SITE CLASS. PS DESIGN FLOW 160 + GROCERY L.T.A.R. 10.25 GPD/FT²

GREASE TRAP (1000) Gallons; STB 99 Date 10/15/93

Pump Tank: (1500) Gallons; PT Date

Pump Make: Model Serial No.

Nitrification Field: No Fields 2 Square Feet 645' Linear Feet 215'

No Lines 2 Trench Width 36" Max Trench Bottom Depth 18-36' Gravel Depth 12"

☐ New System ☑ Repair System Type (I) II, IV, V, VI

System Description: CONV. GRAVITY

Repair System Description:

Maintenance Agreement Required: ☐ Yes ☑ No

☐ House/Mod. Home No. Bedrooms

☐ Mobile Home No. Bathrooms

☐ Business No. Employees

☑ Other GRILL W/ 4 SEATS


☑ Slab ☐ Crawl Space ☐ Basement w/plumbing ☐ Basement wo/plumbing

Water Supply: ☑ Individual ☐ Community ☐ Public WELL


Comments: (1) INSTALL NEW 1000 GAL GREASE TRAP AND TIE INTO EXISTING SEPTIC TANK. (2) INSTAL NEW LINES AS SHOWN CONNECTED TO EXISTING D. BOX BY 3"x250' SCH 40 PVC (3) KEEP SEWER LINE 50' FROM WELL (4) KEEP DRAIN LINES 100' FROM WELL

Comments:

INITIAL SITE SKETCH

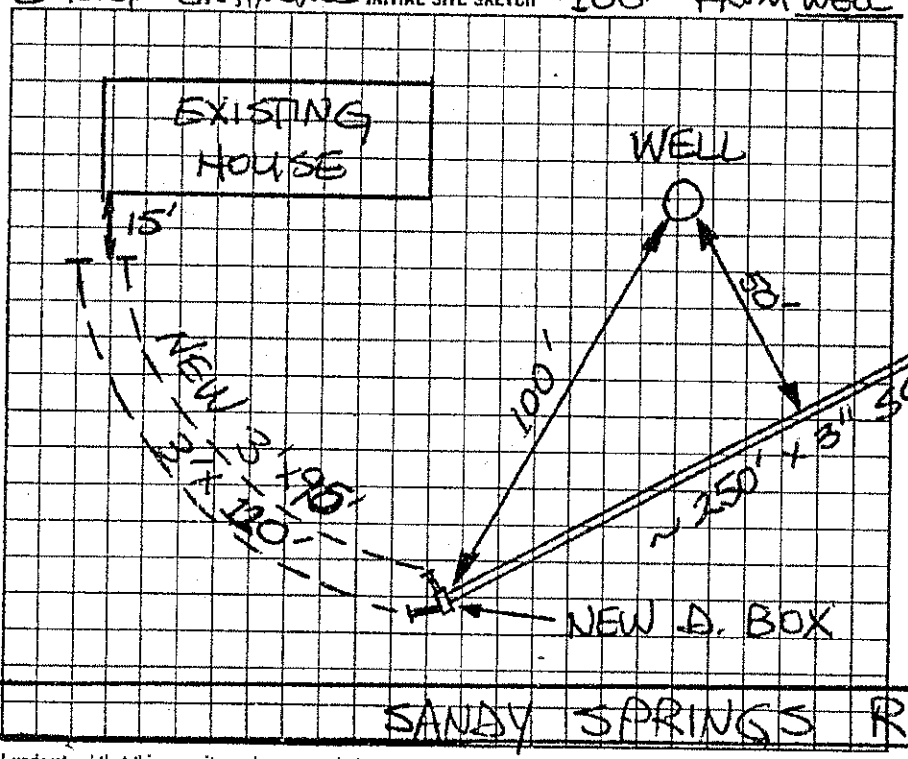

~~AS BUILT SKETCH~~

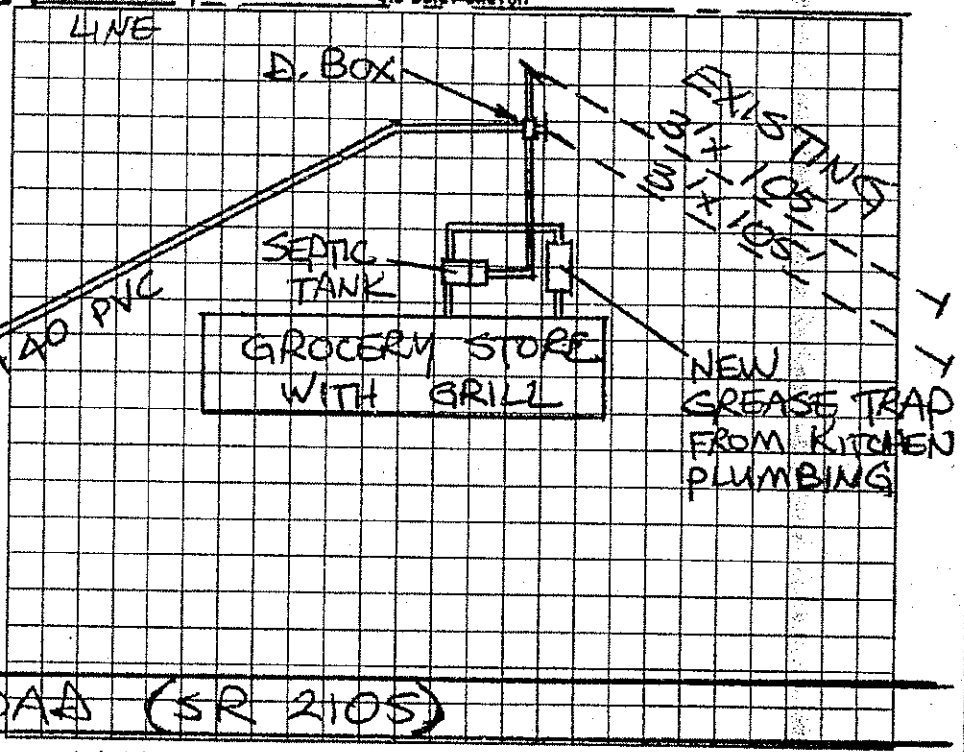

SANDY SPRINGS ROAD (SR 2105)

I understand that this permit can be suspended or revoked if any false information is supplied toward securing the permit/any unauthorized changes are made to the site/any unauthorized changes are made in the installation of the system. Improvement Permit is valid for 60 months from date of issuance.

Signed: x Steve Gunter

Improvement Permit by: STEVE HEDRICK date 2/21/94

Existing System Inspection by: date

Installed by: TOMMY FRYE

Certificate of Completion by: STEVE HEDRICK date 3/7/94

Operation Permit by: date

HEALTH DEPT. COPY: WHITE INSPECTION COPY (FINAL): GREEN OWNER COPY (FINAL): YELLOW INSPECTION COPY (INITIAL): PINK OWNER COPY (INITIAL): GOLD