IREDELL COUNTY HEALTH DEPARTMENT

STATESVILLE 704-878-5305 MOORESVILLE 704-664-5281

IMPROVEMENT PERMIT / CERTIFICATE OF COMPLETION / OPERATION PERMIT / EXISTING SYSTEM INSPECTION

PROPERTY DESCRIPTION NO. 19783 DATE 11/22/94 TAX MAP NO. 17H-A-3A Watershed: ☐ Yes ☒ No

OWNER OR CONTRACTOR LUTHER K CLINARD PHONE: Business Home (910) 766-6324

ADDRESS RT. 6, DOBY ROAD MOCKSVILLE NC 27028

LOCATION US 21 N, TR HOUSTONVILLE RD, TR SANDY SPRINGS RD, TL DOBY ROAD, 1ST D/W MH ON (L) ~0.25 MI

SUBDIVISION ____ BLOCK / SECTION ____ LOT ____ LOT AREA 58 AC SITE CLASS. ____ DESIGN FLOW 360 L.T.A.R. EXISTING

Septic Tank: EXISTING Gallons; STB ____ Date ____

Pump Tank: ____ Gallons; PT ____ Date ____

Pump Make: ____ Model ____ Serial No. ____

Nitrification Field: No Fields 1 Square Feet ____ Linear Feet EXISTING

No Lines ____ Trench Width ____ Max Trench Bottom Depth ____

☐ New System ☐ Repair System Type: I, II, III, IV, V, VI

System Description: CONVENTIONAL GRAVITY

Repair System Description: ____

Maintenance Agreement Required: ☐ Yes ☒ No

☐ Slab ☒ Crawl Space ☐ Basement w/plumbing ☐ Basement wo/plumbing

☐ House/Mod. Home No. Bedrooms 3

☒ Mobile Home No. Bathrooms 2

☐ Business No. Employees ____


☐ Other ____

Water Supply: ☒ Individual ☐ Community ☐ Public WELL


Comments:

Comments: (1) KEEP MH MINIMUM 5' FROM SYSTEM
(2) KEEP WELL MINIMUM 100' FROM SYSTEM

INITIAL SITE SKETCH

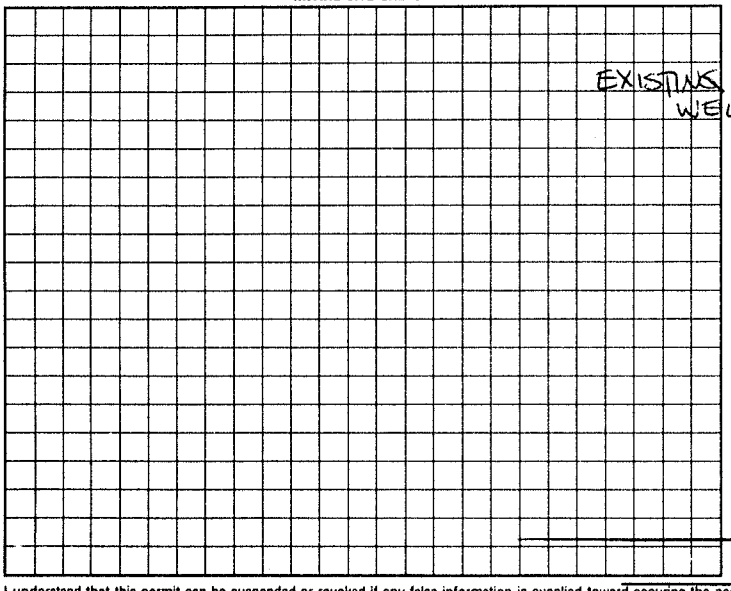

AS BUILT SKETCH

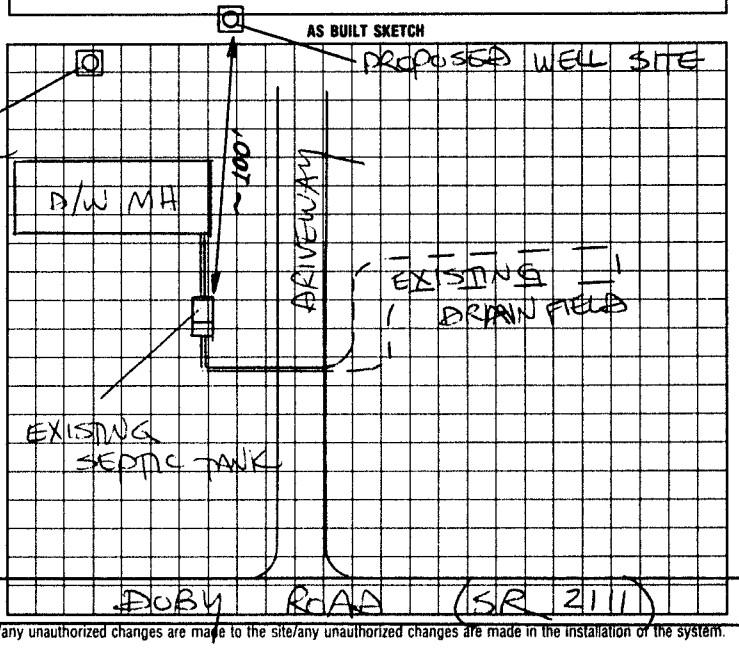

I understand that this permit can be suspended or revoked if any false information is supplied toward securing the permit/any unauthorized changes are made to the site/any unauthorized changes are made in the installation of the system. Improvement Permit is valid for 60 months from date of issuance.

Signed: ____ Installed by: ____

Improvement Permit by: ____ date ____ Certificate of Completion by: ____ date ____

Existing System Inspection by: STEVE HENDRICK date 11/22/94 Operation Permit by: ____ date ____

HEALTH DEPT. COPY: WHITE INSPECTION COPY (FINAL): GREEN OWNER COPY (FINAL): YELLOW INSPECTION COPY (INITIAL): PINK OWNER COPY (INITIAL): GOLD