IREDELL COUNTY HEALTH DEPARTMENT

STATESVILLE 704-878-5305 MOORESVILLE 704-664-5281

IMPROVEMENT PERMIT / AUTHORIZATION TO CONSTRUCT / OPERATION PERMIT / EXISTING SYSTEM INSPECTION

PERMIT# 127706 PIN# 4892-34-~~7038~~ 6049 DATE 6-1-05

OWNER OR CONTRACTOR CARLIE RENEGAR PHONE: Business Home (704) 546-7184

ADDRESS 2221 SANDY SPRINGS RD. MOCKSVILLE, NC 27028

LOCATION I-77N TR HWY 901 TL US 21N TR HOUSTONVILLE TR SANDY SPRINGS LOT ON RT

SUBDIVISION BLOCK / SECTION LOT LOT AREA 34.691 SITE CLASS. PS DESIGN FLOW 360 L.T.A.R. UPGRADED TO 0.30 GPD/FT²

Septic Tank: EXISTING Gallons; STB Date

Pump Tank: Gallons; PT Date

Pump Make: Model Serial No.

Nitrification Field: No. Fields 1 Square Feet Linear Feet 280

No Lines FOUR (4) Trench Width 36" Max Trench Bottom Depth 36" Gravel Depth 12"

☑ New System ☐ Repair System Type: I, II, III, IV, V, VI

System Description: CONVENTIONAL GRAVITY

Repair System Description: LP PIPES 50% REDUCTION

Maintenance Agreement Required: ☐ Yes ☑ No

☐ House/Mod. Home No. Bedrooms 3

☑ Mobile Home No. Bathrooms

☐ Business No. Employees

☐ Other


☐ Slab ☑ Crawl Space ☐ Basement w/plumbing ☐ Basement wo/plumbing

Water Supply: ☑ Individual ☐ Public ☐ Community

Comments:/Conditions: ① INSTALL SYSTEM ON CONTOUR ② ~~NOT~~ MAINTAIN SETBACKS ③ INSTALL ACCORDING TO SKETCH

Comments:/Conditions: ① #5 STONE ② ZOELLER TRU-FLOW SPLITTER USED TO DISTRIBUTE EFFLUENT

INITIAL SITE SKETCH

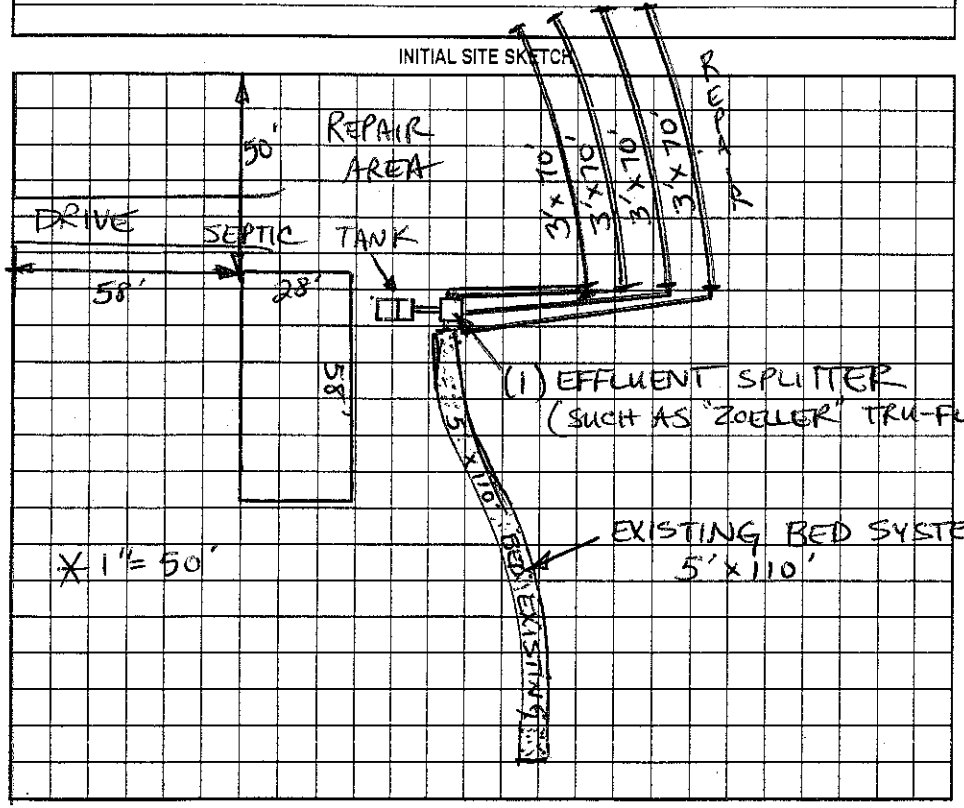

AS BUILT SKETCH

SYSTEM INSTALLED ACCORDING TO SKETCH

SANDY SPRINGS ROAD

Permit can be suspended or revoked if any false information is supplied toward securing the permit/any unauthorized changes are made to the site/any unauthorized changes are made in the installation of the system. Improvement Permit with plat valid without expiration. Improvement Permit with site plan valid for sixty months. Authorization to Construct is valid for a period equal to that of Improvement Permit – not to exceed sixty months.

Signed: Geneva K. Renegar date 6-02-05 Installed by: SAMMY REAVIS

Improvement Permit by: Christopher M. Shearin LRS, LSS date 6-1-05 Operation Permit by: Christopher M. Shearin LRS, LSS date 6-13-05

Authorization to Construct by: Christopher M. Shearin LRS, LSS date 6-1-05 Existing System Inspection by: date

HEALTH DEPT. COPY: WHITE OWNER COPY (FINAL): YELLOW OWNER COPY (INITIAL): PINK