IREDELL COUNTY HEALTH DEPARTMENT

STATESVILLE 704-878-5305 MOORESVILLE 704-664-5281

IMPROVEMENT PERMIT / AUTHORIZATION TO CONSTRUCT / OPERATION PERMIT / EXISTING SYSTEM INSPECTION

PERMIT# REPAIR PIN#

OWNER OR CONTRACTOR JERRY ELLER PHONE: Business Home (336) 463-5609 DATE 2-9-01

ADDRESS 2100 MAYNARD ROAD, YADKINVILLE, NC 27055

LOCATION US 21 N, TR POWELL RD, TL TURKEY FOOT, TL SANDY SPRINGS, ON RIGHT BEFORE GUYERS STORE

SUBDIVISION BLOCK / SECTION LOT LOT AREA ~56 ACRES SITE CLASS PS DESIGN FLOW 480 L.T.A.R. 0.35 GPD/FT²

Septic Tank: 1000 Gallons: STB 760 Date 12-15-00
Pump Tank: Gallons: PT Date
Pump Make: Model Serial No
Nitrification Field: No Fields 1 Square Feet 1380 Linear Feet 460
No Lines SIX Trench Width 36" Max Trench Bottom Depth 36 Gravel Depth 12"

~~New System~~ ✓ Repair System Type: I II III IV V VI
System Description: CONVENTIONAL GRAVITY
Repair System Description: CONV. GRAVITY
Maintenance Agreement Required: ☐ Yes ☑ No
☐ Slab ☑ Crawl Space ☐ Basement w/plumbing ☐ Basement wo/plumbing


☑ House/Mod. Home No. Bedrooms 4
☐ Mobile Home No. Bathrooms 2
☐ Business No. Employees
☐ Other

Water Supply: ~~Individual~~ ☐ Public ☐ Community WELL

Comments/Conditions: ABANDON EXISTING WELL AT HOUSE BY FILLING WITH CONCRETE

Comments/Conditions SEPTIC TANK W/ RISERS INSTALLED USING "ZABEL" FILTER

INITIAL SITE SKETCH

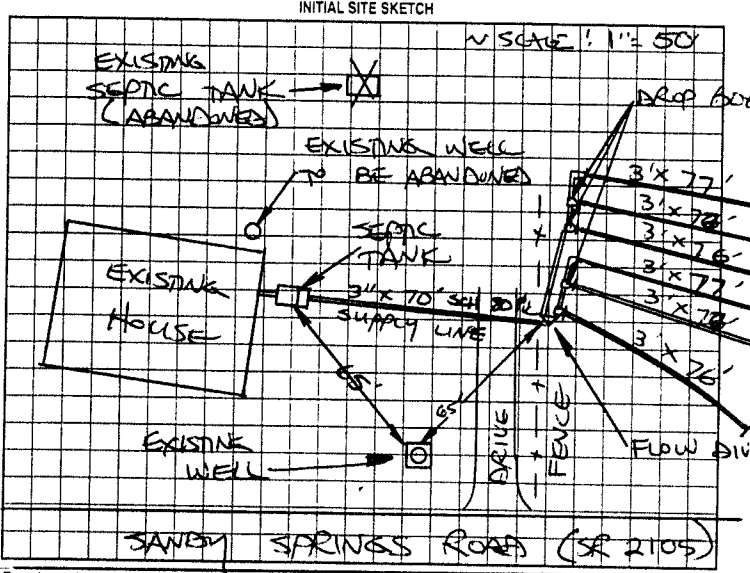

AS BUILT SKETCH

SYSTEM INSTALLED ACCORDING TO INITIAL SITE SKETCH

Permit can be suspended or revoked if any false information is supplied toward securing the permit/any unauthorized changes are made to the site/any unauthorized changes are made in the installation of the system. Improvement Permit with plat valid without expiration. Improvement Permit with site plan valid for sixty months. Authorization to Construct is valid for a period equal to that of Improvement Permit – not to exceed sixty months.

Signed: Bonnie Boyce date 2-9-01 Installed by: BOBBY ELLER

Improvement Permit by: STEVE HEDRICK date 2-9-01 Operation Permit by: STEVE HEDRICK date 3-2-01

Authorization to Construct by: STEVE HEDRICK date 2-9-01 Existing System Inspection by: date

HEALTH DEPT. COPY WHITE OWNER COPY (FINAL) YELLOW OWNER COPY (INITIAL) PINK