IREDELL COUNTY HEALTH DEPARTMENT

Statesville Office (704) 878-5305 Mooresville Office (704) 660-3625 PERMIT # 208723

IMPROVEMENT PERMIT / AUTHORIZATION TO CONSTRUCT / OPERATION PERMIT / EXISTING SYSTEM

PIN # 4892526841

APPLICANT: Selena Swaim APPLICANT ADDRESS: 119 Turkey Hill Ln Harmony NC 28634

SITE ADDRESS: 1117 Powell Bridge Rd Harmony NC 28634 PHONE: 336-409-5520 ALT. PHONE: 704-881-1609

SITE DIRECTIONS: Hwy 21 N T/L Powell Bridge Rd Property on left on end


SUBDIVISION: N/A SECTION: N/A LOT # N/A LOT AREA: 9.4ac DESIGN FLOW: 240 L.T.A.R.: 0.25

Septic Tank	1000	(gal)	STB	760	Date	9-10-14	[X] New System	[ ] Repair	[ ] Expansion	System Type: I II III IV V VI	
Pump Tank	N/A	(gal)	PT	N/A	Date	N/A	System Description:	25% Reduction			
Pump Make	N/A	Model		Poly Flo	Serial #	PL-68	Repair System Description:	25% Reduction			
# Nitrification Fields	1	# Lines		2	Linear Ft:	240	Maintenance Agreement Required:	[ ] YES	[X] NO		
Trench Width	36"	Max. Trench Bottom Depth		30"	Gravel Depth	N/A	[X] GRAVITY	[ ] PRESSURE			

[X] Residence	No. Bedrooms	2	Water Supply	
[ ] Business	No. Persons	4	[ ] Private	
[ ] Other	No. Employees		[X] Public	
[ ] Slab	[ ] Crawl Space		[ ] Community	
[ ] Basement w/plumbing			[ ] Basement w/o plumbing	

Comments / Conditions: Install 25% reduction on contour with serial distribution

INITIAL SITE SKETCH

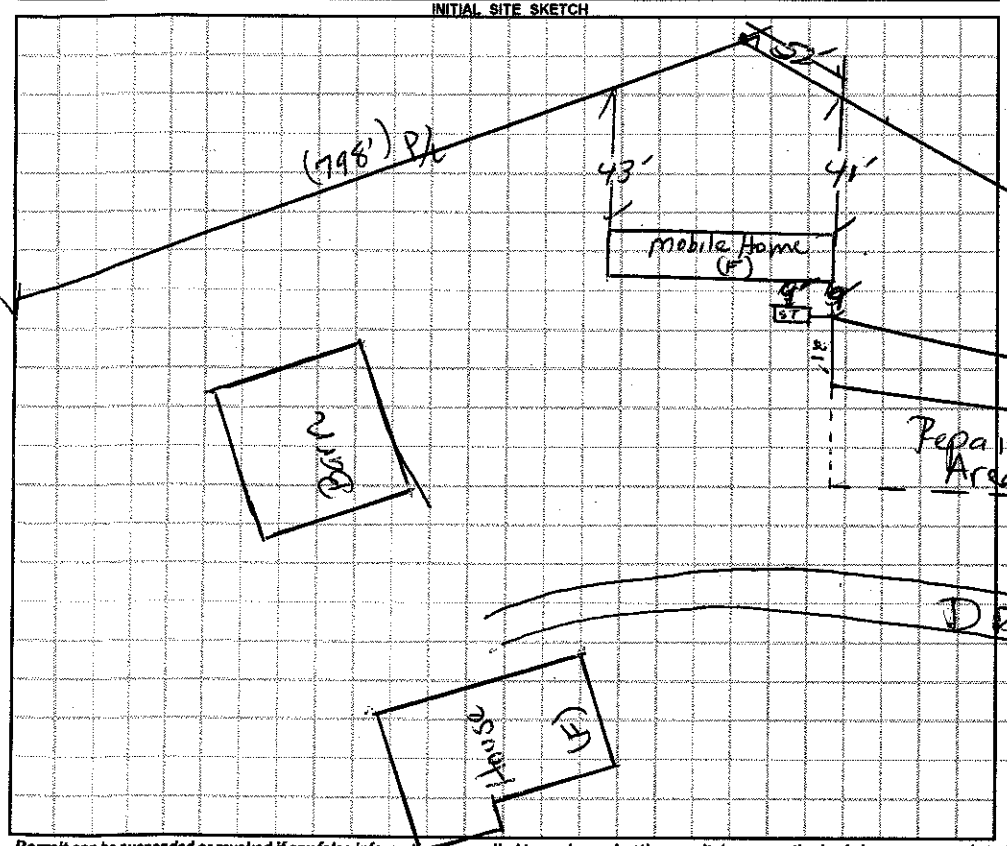

AS BUILT SKETCH

1"=60

Installed Quick 4 as drawn

Permit can be suspended or revoked if any false information is supplied toward securing the permit / any unauthorized changes are made to the site / any unauthorized changes are made in the installation of the system. **CONTACT A LOCATOR SERVICE PRIOR TO ANY EXCAVATION**

[ ] **IMPROVEMENT PERMIT** *with plat valid without expiration.* [X] **IMPROVEMENT PERMIT** *with site plan valid for 60 mos.* [X] **AUTHORIZATION TO CONSTRUCT** *valid for period equal to IMPROVEMENT PERMIT--not to exceed 60 mo.*

Owner / Applicant Signature: Date: 3/20/15 Installed by: Gunter Grading

IMPROVEMENT PERMIT by: Date: 03/18/15 OPERATION PERMIT by: Date: 03/26/15

AUTHORIZATION TO CONSTRUCT by: Date: 03/20/15 Existing System Inspected by: Date:

Health Dept. Copy - WHITE Applicant (Final Approval) - YELLOW Applicant (Conditional Approval) - PINK