100 Sherman Dunn.

IREDELL COUNTY HEALTH DEPARTMENT

STATESVILLE 704-878-5305 MOORESVILLE 704-664-5281

IMPROVEMENT PERMIT / AUTHORIZATION TO CONSTRUCT / OPERATION PERMIT / EXISTING SYSTEM INSPECTION

PERMIT# 071008 PIN# 4892540342 DATE 1-2-98

OWNER OR CONTRACTOR TIMOTHY HODGE PHONE: Business Home 546-7560

ADDRESS 698 Rock SPRINGS ROAD, HARMONY NC 28634

LOCATION US 21 N, TR POWELL, TL TURKEY FOOT, TL SANDY SPRINGS, 850 FEET ON LEFT

SUBDIVISION BLOCK / SECTION LOT LOT AREA 2.10 ACRES SITE CLASS. P3 DESIGN FLOW 360 L.T.A.R. 0.30 GPD/FT²

Septic Tank: 1000 Gallons; STB 760 Date 1-25-98
Pump Tank: Gallons; PT Date
Pump Make: Model Serial No.
Nitrification Field: No Fields 1 Square Feet 1200 Linear Feet 400
No Lines FOUR Trench Width 36" Max Trench Bottom Depth 36" Gravel Depth 12"

☑ New System ☐ Repair System Type: I (II) III, IV, V, VI
System Description: CONVENTIONAL GRAVITY
Repair System Description: CONV. GRAVITY
Maintenance Agreement Required: ☐ Yes ☑ No
☐ Slab ☑ Crawl Space ☐ Basement w/plumbing ☐ Basement wo/plumbing


☐ House/Mod. Home No. Bedrooms 3
☑ Mobile Home No. Bathrooms 2
☐ Business No. Employees
☐ Other

Water Supply: ☑ Individual ☐ Public ☐ Community WELL


Comments:/Conditions: ① KEEP SYSTEM MINIMUM 100' FROM WELL ② NO CUTTING OR FILLING OF SOIL OVER DRAINFIELD

Comments:/Conditions:

INITIAL SITE SKETCH SCALE: 1"=50'

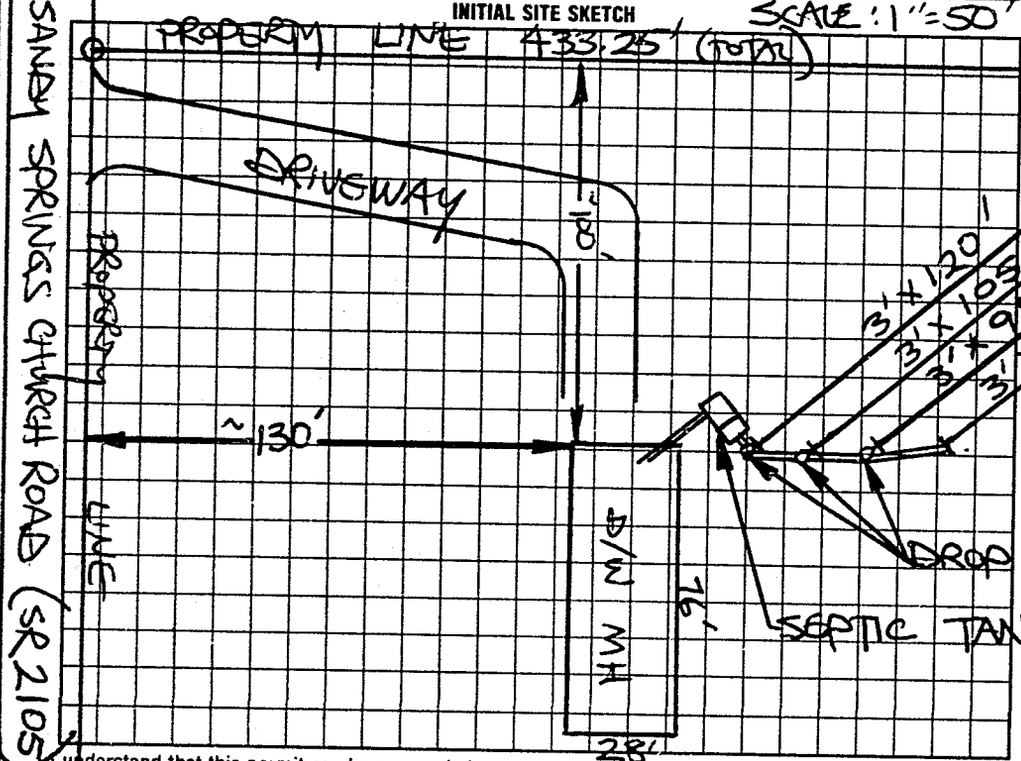

AS BUILT SKETCH

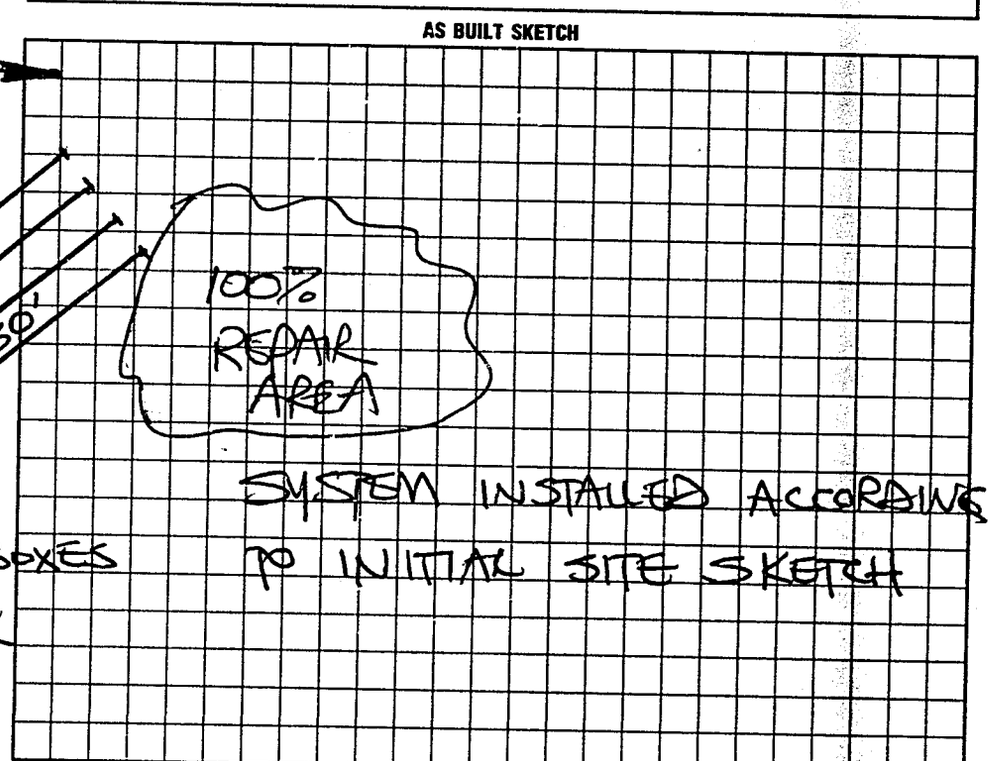

I understand that this permit can be suspended or revoked if any false information is supplied toward securing the permit/any unauthorized changes are made to the site/any unauthorized changes are made in the installation of the system. Improvement Permit with plat valid without expiration. Improvement Permit with site plan valid for sixty months. Authorization to Construct is valid for a period equal to that of Improvement Permit – not to exceed sixty months.

Signed: x Timothy L. Hodge date

Improvement Permit by: STEVE HEDRICK date 1-2-98

Authorization to Construct by: STEVE HEDRICK date 1-2-98

Installed by: SHERMAN DUNN

Operation Permit by: STEVE HEDRICK date 4-7-98

Existing System Inspection by: date

HEALTH DEPT COPY WHITE INSPECTION COPY (FINAL) GREEN OWNER COPY (FINAL) YELLOW INSPECTION COPY (INITIAL) PINK OWNER COPY (INITIAL) GOLD