IREDELL COUNTY HEALTH DEPARTMENT

STATESVILLE 704-878-5305 (KD) (AW) MOORESVILLE 704-664-5281

IMPROVEMENT PERMIT / AUTHORIZATION TO CONSTRUCT / OPERATION PERMIT / EXISTING SYSTEM INSPECTION

PERMIT# 139122 PIN# 4892599804 DATE 11-13-06

OWNER OR APPLICANT James Stach PHONE: Business _____ Home 941-875-4834

ADDRESS 6071 Gillot BLVD Port Charlotte FL 33981

LOCATION 21N to Powell Bridge to Sandy Springs across from market

SUBDIVISION _____ BLOCK / SECTION _____ LOT _____ LOT AREA 2+ SITE CLASS 3 DESIGN FLOW 480 L.T.A.R. 3

Septic Tank: 1000 Gallons: ST8 760 Date 3-14-06

Pump Tank: _____ Gallons: PT _____ Date _____

Pump Make: _____ Model _____ Serial No. _____

Nitrification Field: No Fields ___ Square Feet 1600 Linear Feet 400

No Lines 4 Trench Width 36" Max Trench Bottom Depth 36" Gravel Depth NA

☒ New System ☐ Repair ☐ Expansion System Type: I (II) III IV V VI

System Description: 2590 Gravity

Repair System Description: 2590 Gravity

Maintenance Agreement Required: ☐ Yes ☒ No

☒ House/Mod. Home ☐ Mobile Home ☐ Business ☐ Other

No. Bedrooms 4 No. Persons ___ No. Employees ___


Water Supply: ☒ Individual ☐ Public ☐ Community

☒ Gravity ☐ Pressure ☐ Slab ☐ Crawl Space ☒ Basement w/plumbing ☐ Basement wo/plumbing

Comments/Conditions: Install on Contour Maintain all setbacks Drive Attached Garage well

Comments/Conditions: Red filter

INITIAL SITE SKETCH

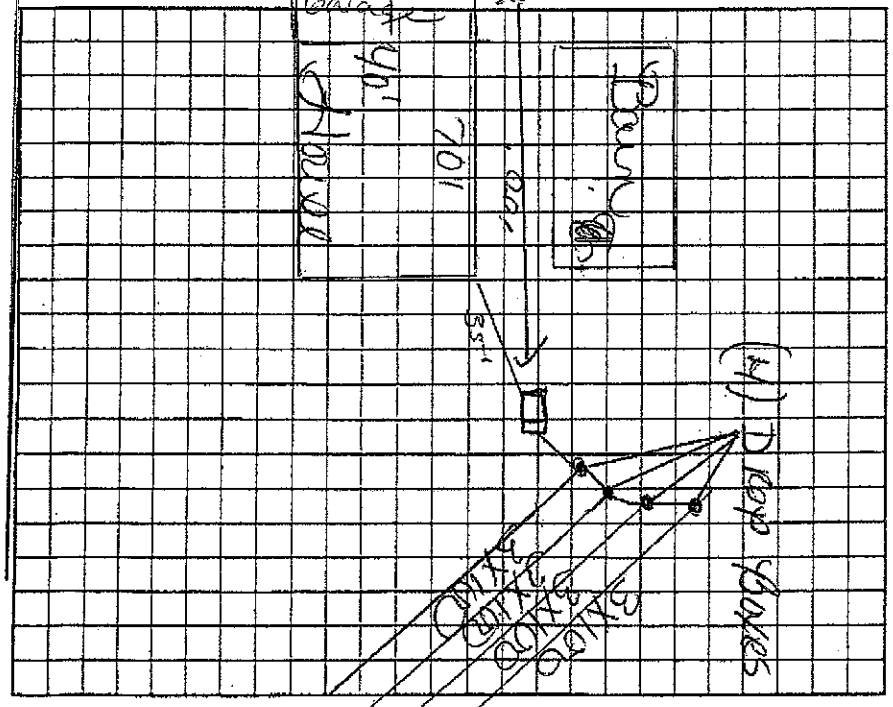

AS BUILT SKETCH

location of the proposed Attached Garage addition does not appear to impact the existing on-site septic system.**NOTE:

Justin Henderson REHS

Date: 11-8-13

ICHD-Environmental Health Division

Permit can be suspended or revoked if any false information is supplied toward securing the permit/any unauthorized changes are made to the site/any unauthorized changes are made in the installation of the system. Improvement Permit with plat valid without expiration ☐ Improvement Permit with site plan valid for sixty months ☐ Authorization to Construct is valid for a period equal to that of Improvement Permit – not to exceed sixty months.

Signed: Justin Stach date 11-30-06 Installed by: A-1 Backhoe

Improvement Permit by: Keith Cook date 11-13-06 Operation Permit by: _____ date 6-10-08

Authorization to Construct by: Keith Cook date 11-13-06 Existing System Inspection by: _____ date _____

HEALTH DEPT. COPY: WHITE OWNER COPY (FINAL): YELLOW OWNER COPY (INITIAL): PINK

Sandy Springs