IREDELL COUNTY HEALTH DEPARTMENT

STATESVILLE 704-878-5305 MOORESVILLE 704-664-5281

IMPROVEMENT PERMIT / AUTHORIZATION TO CONSTRUCT / OPERATION PERMIT / EXISTING SYSTEM INSPECTION

PERMIT# 088339 PIN# 4892 59 6286 (PART) DATE 11-9-00

OWNER OR CONTRACTOR EDGAR LEE TRIVETTE PHONE: Business LEE CELL #: 902-3052 Home 872-4203

ADDRESS 104 CRIPLE CREEK LANE, STATESVILLE, NC 28677

LOCATION US 21 N, TR E HOUSTONVILLE ROAD, TR SANDY SPRINGS ROAD, TL DOBY ROAD, 0.5 MILE ON RIGHT, 20' BACK

SUBDIVISION _____ BLOCK / SECTION _____ LOT _____ LOT AREA 37.67 Acres SITE CLASS: PS DESIGN FLOW 360 L.T.A.R. 0.25 GPD/FT²

Septic Tank: 1000 Gallons; STB 156 Date 12-16-00
Pump Tank: _____ Gallons; PT _____ Date _____
Pump Make: _____ Model _____ Serial No. _____
Nitrification Field: No. Fields 1 Square Feet 1440 Linear Feet 480
No. Lines SIX Trench Width 36" Max Trench Bottom Depth 30" Gravel Depth 12"

☑ New System ☐ Repair System Type: I (II) III IV V VI
System Description: CONVENTIONAL GRAVITY
Repair System Description: CONV. GRAVITY
Maintenance Agreement Required: ☐ Yes ☑ No


☐ House/Mod. Home No. Bedrooms 3
☑ Mobile Home No. Bathrooms 2
☐ Business No. Employees ____
☐ Other _____

☐ Slab ☑ Crawl Space ☐ Basement w/plumbing ☐ Basement wo/plumbing

Water Supply: ~~☑~~ Individual ☐ Public ☐ Community WELL


Comments/Conditions: ① INSTALL SUBSURFACE INTERCEPT DRAINAGE DITCH BEGINNING 42" DEEP OUT TO DAYLIGHT. ② USE ONE FLOW DIVIDER TEE TO ACHIEVE EQUAL DISTRIBUTION INTO TWO DIST. BOXES FEEDING THREE LINES EACH.

INITIAL SITE SKETCH

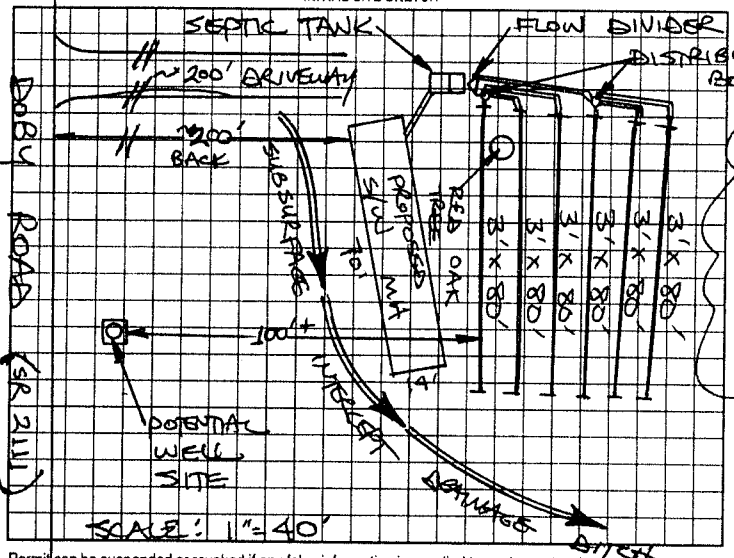

Comments/Conditions: ① SEPTIC TANK W/ MARKER INSTALLED USING "BABEL" FILTER. ② TANK & DRAINFIELD INSTALLED 5-16-01 ~~SUBSURFACE INTERCEPT DRAINAGE DITCH REMAINS~~ TO BE INSTALLED.

AS BUILT SKETCH

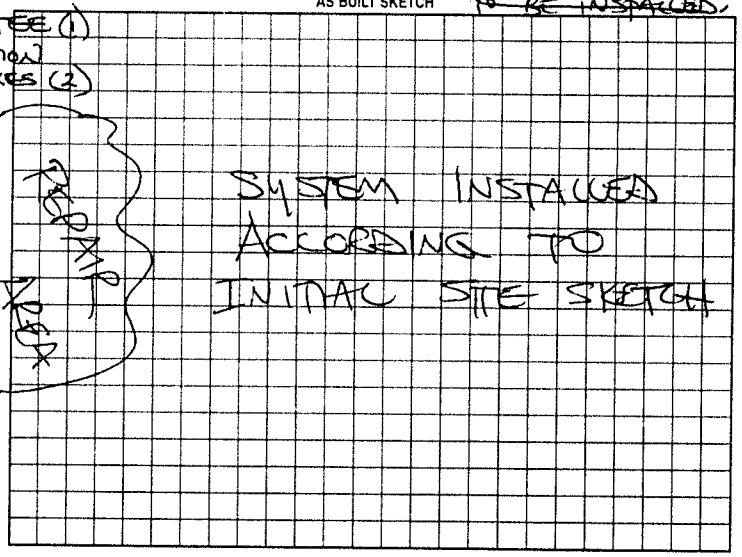

Permit can be suspended or revoked if any false information is supplied toward securing the permit, any unauthorized changes are made to the site/any unauthorized changes are made in the installation of the system. Improvement Permit with plat valid without expiration. Improvement Permit with site plan valid for sixty months. Authorization to Construct is valid for a period equal to that of Improvement Permit – not to exceed sixty months.

Signed: Lee Trivette date 11-9-00 Installed by: SHERMAN DUNN

Improvement Permit by: STEVE HEDRICK date 11-9-00 Operation Permit by: STEVE HEDRICK date 6-11-01

Authorization to Construct by: STEVE HEDRICK date 11-9-00 Existing System Inspection by: _____ date _____

HEALTH DEPT. COPY: WHITE OWNER COPY (FINAL): YELLOW OWNER COPY (INITIAL): PINK