IREDELL COUNTY HEALTH DEPARTMENT

STATESVILLE 704-878-5305 MOORESVILLE 704-664-5281

IMPROVEMENT PERMIT / AUTHORIZATION TO CONSTRUCT / OPERATION PERMIT / EXISTING SYSTEM INSPECTION

PERMIT# 087677 PIN# 4892 50 4691 (PART) DATE 2-25-00

OWNER OR CONTRACTOR HOME MAX PHONE: Business (336) 751-7340 Home

ADDRESS 153 BLASIE CHURCH ROAD, MOCKSVILLE, NC 27028

LOCATION US 21 N, TR POWELL RD, TR TURKEYFOOT RD, TR ROCK SPRINGS ROAD, 4TH LOT ON RIGHT

SUBDIVISION RICHARD KETCHIE BLOCK / SECTION ____ LOT 1 LOT AREA 1.480 ACRES SITE CLASS. PS DESIGN FLOW 360 L.T.A.R. 0.40 GPD/FT²

Septic Tank: 1000 Gallons; STB 1012 Date 11-14-99
Pump Tank: ____ Gallons; PT ____ Date ____
Pump Make: ____ Model ____ Serial No. ____
Nitrification Field: No Fields 1 Square Feet 900 Linear Feet 300
No Lines FOUR Trench Width 36" Max Trench Bottom Depth 36" Gravel Depth 12"

☑ New System ☐ Repair System Type: I (II) III. IV. V. VI
System Description: CONVENTIONAL GRAVITY
Repair System Description: 50% REDUCTION GRAVITY
Maintenance Agreement Required: ☐ Yes ☑ No
☐ Slab ☑ Crawl Space ☐ Basement w/plumbing ☐ Basement wo/plumbing


☐ House/Mod. Home No. Bedrooms 3
☑ Mobile Home No. Bathrooms 2
☐ Business No. Employees ____
☐ Other ____

Water Supply: ☑ Individual ☐ Public ☐ Community WELL


Comments/Conditions: ① KEEP SYSTEM MAXIMUM FEASIBLE DISTANCE (80 FEET) FROM WELL, ② INSTALL SUBSURFACE INTERCEPT DRAINAGE DITCH AT LOCATION SHOWN BEGINNING 42" DEEP.

Comments/Conditions: ① SEPTIC TANK W/ RISERS AND MARKER INSTALLED USING "POLYLOK" FILTER ② SYSTEM INSTALLED IN WET SOIL CONDITIONS

SCALE: 1" = 40' INITIAL SITE SKETCH

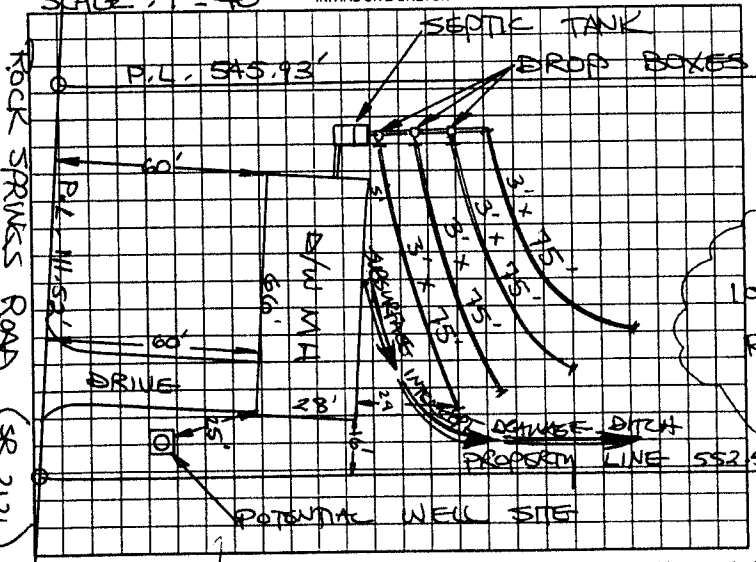

AS BUILT SKETCH

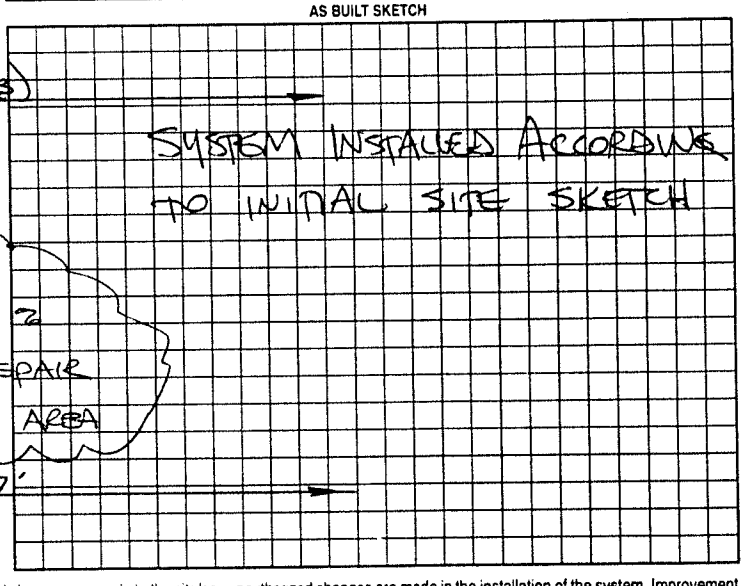

Permit can be suspended or revoked if any false information is supplied toward securing the permit/any unauthorized changes are made to the site/any unauthorized changes are made in the installation of the system. Improvement Permit with plat valid without expiration. Improvement Permit with site plan valid for sixty months. Authorization to Construct is valid for a period equal to that of Improvement Permit – not to exceed sixty months.

Signed: [signature] date 2-28-00 Installed by: A-1 BACKHOE

Improvement Permit by: STEVE HEDRICK date 2-25-00 Operation Permit by: STEVE HEDRICK date 3-22-00

Authorization to Construct by: STEVE HEDRICK date 2-25-00 Existing System Inspection by: ____ date ____

HEALTH DEPT. COPY WHITE OWNER COPY (FINAL) YELLOW OWNER COPY (INITIAL) PINK