IREDELL COUNTY HEALTH DEPARTMENT

STATESVILLE 704-878-5305 MOORESVILLE 704-664-5281

IMPROVEMENT PERMIT / AUTHORIZATION TO CONSTRUCT / OPERATION PERMIT / EXISTING SYSTEM INSPECTION

PERMIT# 081441 PIN# 4892 620322 DATE 5-26-99

OWNER OR CONTRACTOR FRANCES KIMBRELL PHONE: Business (704) 940-5820 Home (336) 751-7749

ADDRESS 2034 ANGEL ROAD, MOCKSVILLE, NC 27028

LOCATION US 21 N, TR POWELL BRIDGE RD, 3RD LOT ON RIGHT BEFORE TURKEYFOOT ROAD

SUBDIVISION ROCK SPRING ACRES BLOCK / SECTION ____ LOT 3 LOT AREA 2.00 ACRES SITE CLASS PS DESIGN FLOW 360 L.T.A.R. 0.30 GPD/FT²

Septic Tank: 1000 Gallons: STB 760 Date 2-23-99
Pump Tank: ____ Gallons: PT ____ Date ____
Pump Make: ____ Model ____ Serial No. ____
Nitrification Field: No Fields 1 Square Feet 1200 Linear Feet 400
No Lines FIVE Trench Width 36" Max Trench Bottom Depth 36" Gravel Depth 12"

✓ New System ☐ Repair System Type: I II III IV V VI
System Description: CONVENTIONAL GRAVITY
Repair System Description: CONVENTIONAL GRAVITY
Maintenance Agreement Required: ☐ Yes ✓ No


✓ House/Mod. Home No. Bedrooms 3
✓ Mobile Home No. Bathrooms 2
☐ Business No. Employees ____
☐ Other ____
☐ Slab ✓ Crawl Space ☐ Basement w/plumbing ☐ Basement wo/plumbing

Water Supply: ✓ Individual ☐ Public ☐ Community
WELL


Comments/Conditions: KEEP SYSTEM MINIMUM 100 FEET FROM WELL

Comments/Conditions: ① SEPTIC TANK WITH RISERS INSTALLED USING "ZABEL" A1800 FILTER
② SYSTEM INSTALLED ACCORDING TO INITIAL SITE SKETCH

INITIAL SITE SKETCH

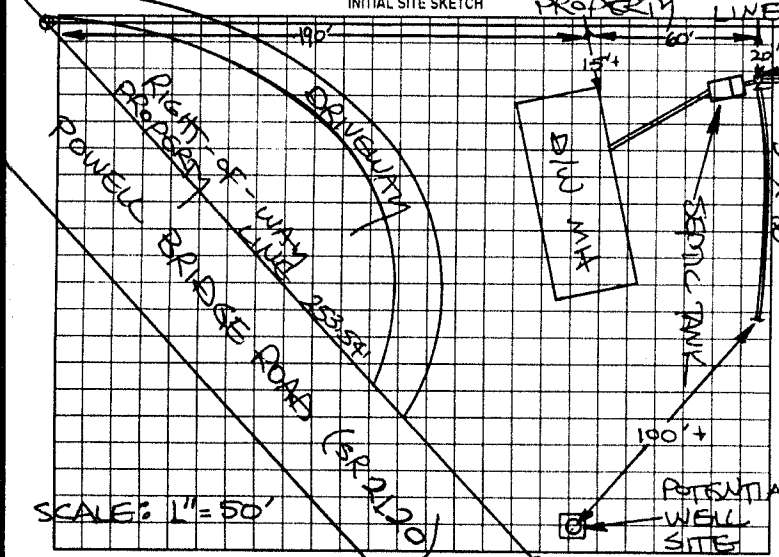

AS BUILT SKETCH

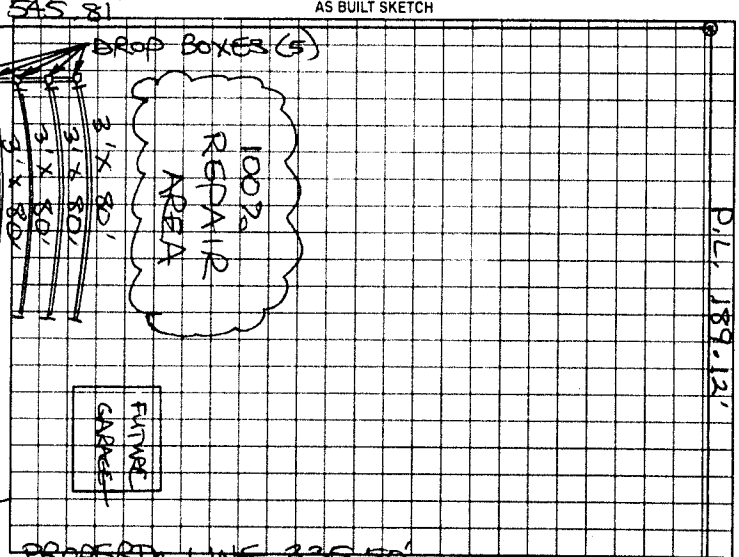

Permit can be suspended or revoked if any false information is supplied toward securing the permit/any unauthorized changes are made to the site/any unauthorized changes are made in the installation of the system. Improvement Permit with plat valid without expiration. Improvement Permit with site plan valid for sixty months. Authorization to Construct is valid for a period equal to that of Improvement Permit - not to exceed sixty months.

Signed: [signature] date 5-26-99

Improvement Permit by: STEVE HEDRICK date 5-26-99

Authorization to Construct by: STEVE HEDRICK date 5-26-99

Installed by: SHERMAN DUNN

Operation Permit by: STEVE HEDRICK date 6-3-99

Existing System Inspection by: ____ date ____

HEALTH DEPT COPY WHITE OWNER COPY (FINAL) YELLOW OWNER COPY (INITIAL) PINK