IREDELL COUNTY HEALTH DEPARTMENT - *ENVIRONMENTAL HEALTH* ☒ STATESVILLE OFFICE 704-878-5305 ☐ MOORESVILLE OFFICE 704-664-5281

IMPROVEMENT PERMIT / AUTHORIZATION TO CONSTRUCT / OPERATION PERMIT / EXISTING SYSTEM INSPECTION

PERMIT # Repair PIN # 4892-62-1729 DATE 18 May 2011

OWNER Annie Wright APPLICANT: Maria Knight PHONE: Home/Cell # (336-464-6234 Business #

SITE ADDRESS 162 Turkey Foot Rd Harmony OWNER / APPLICANT ADDRESS

SITE DIRECTIONS Intersection of Powell Bridge Rd. & Turkey Foot Rd.

SUBDIVISION BLOCK / SECTION LOT # LOT AREA 1.0 Ac± DESIGN FLOW 360 gpd L.T.A.R. 0.3 gpd

Septic Tank ~~1000~~ 1000 Gallons: STB 760 Date 10-19 | ☐ New System ☑ Repair ☐ Expansion System Type I II (III) IV V VI | ☑ Residence No. Bedrooms 3 | Water Supply ☑ Private – exist ☑ Public ☐ Community

Pump Tank Gallons: PT Date | System Description: | ☐ Business No. Persons


Pump Make Model Serial # | Repair System Description: 25% Reduction | ☐ Other No. Employees

No. Nitrification Fields: 1 No. Lines 4 Linear Feet 300 | Maintenance Agreement Required ☐ YES ☑ NO | ☐ Slab ☑ Crawl Space


Trench Width 36" Max. Trench Bottom Depth 36" Gravel Depth NA | ☑ GRAVITY ☐ PRESSURE | ☐ Basement w/plumbing ☐ Basement w/o plumbing

Comments / Conditions * Keep 50'± From old well / ST Was Risers / Polylock filter tee (ml)

INITIAL SITE SKETCH

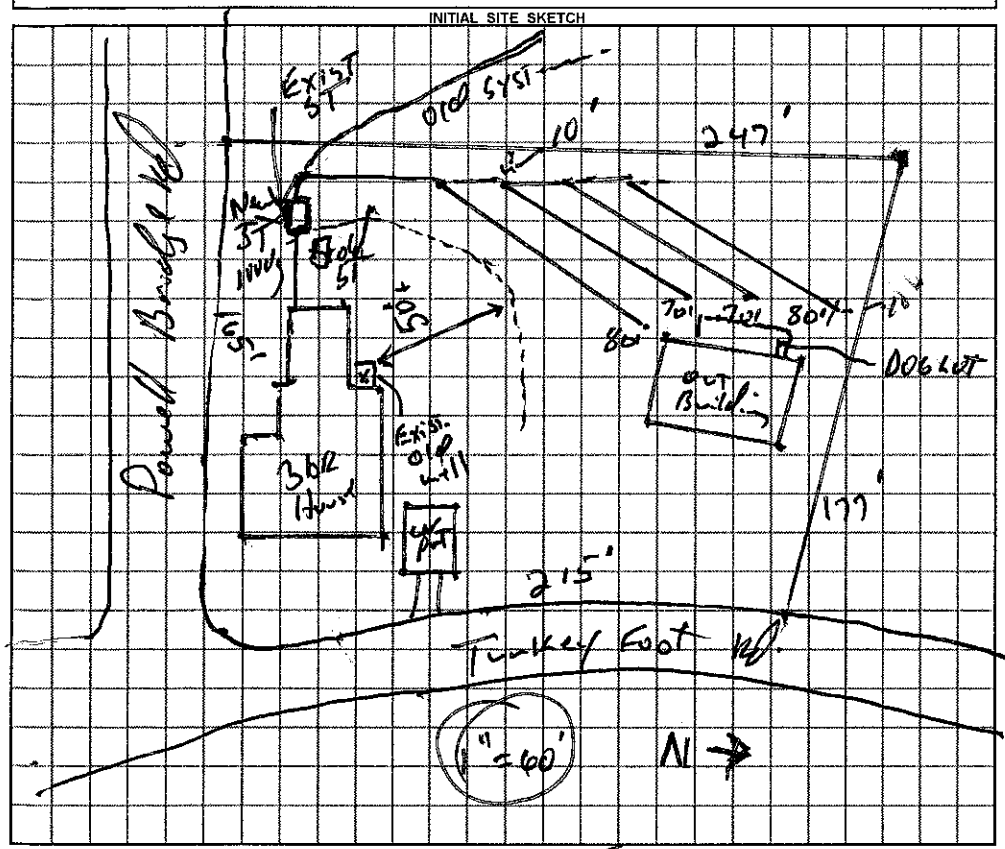

AS BUILT SKETCH

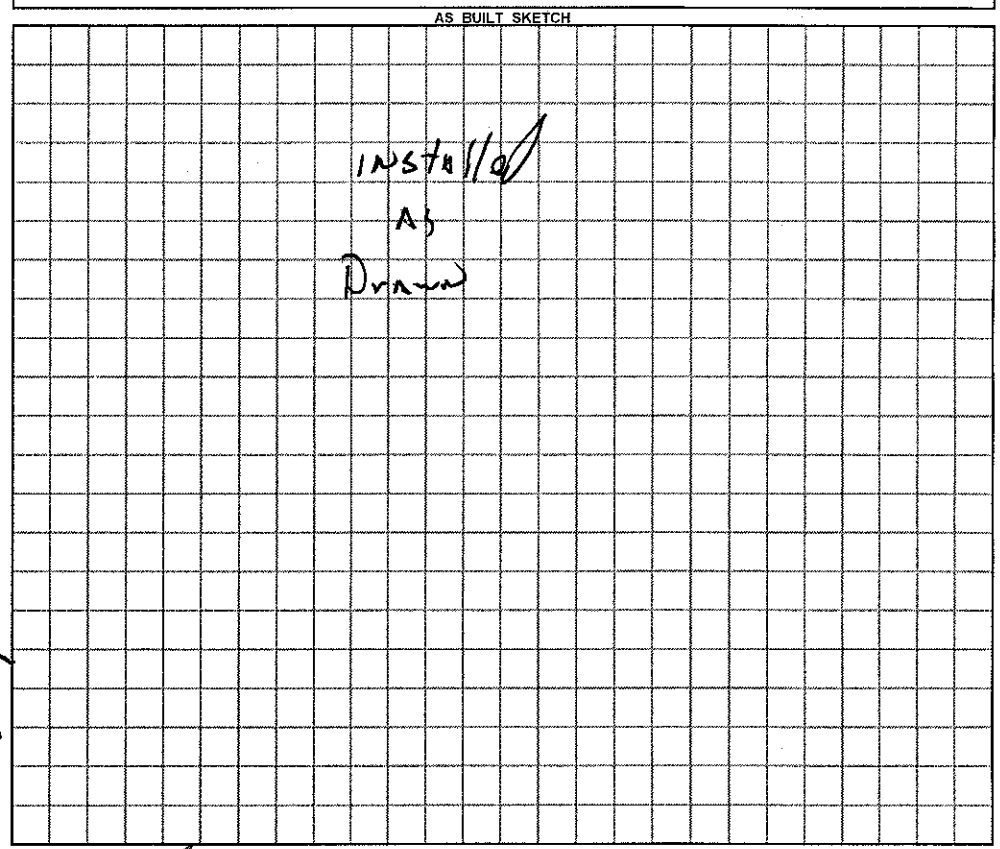

Permit can be suspended or revoked if any false information is supplied toward securing the permit / any unauthorized changes are made to the site / any unauthorized changes are made in the installation of the system.

☐ ***IMPROVEMENT PERMIT*** with plat valid without expiration. ☑ ***IMPROVEMENT PERMIT*** with plat valid without expiration. site plan valid 60 mo. ☑ ***AUTHORIZATION TO CONSTRUCT*** valid for period equal to IMPROVEMENT PERMIT--not to exceed 60 mo.

Owner / Applicant Signature: Maria Knight Date 5/19/11 Installed by: Eric Lakey

IMPROVEMENT PERMIT by: REHS Date 18 May 11 OPERATION PERMIT by: REHS Date 9 June 11

AUTHORIZATION TO CONSTRUCT by: REHS Date 18 May 11 Existing System Inspected by: REHS Date

YOU SHOULD CONTACT A LOCATOR SERVICE PRIOR TO ANY EXCAVATION

White Copy – Environmental Health YELLOW COPY (Final) Owner / Applicant PINK COPY (Initial) Owner / Applicant