2:10

IREDELL COUNTY HEALTH DEPARTMENT

(W) STATESVILLE 704-878-5305 (@) MOORESVILLE 704-664-5281

IMPROVEMENT PERMIT / AUTHORIZATION TO CONSTRUCT / OPERATION PERMIT / EXISTING SYSTEM INSPECTION

PERMIT# 160037 PIN# 4892622439 2545 DATE 3-29-10

OWNER OR CONTRACTOR Katherine Wurzun PHONE: Business _____ Home 704 546 2823

ADDRESS 1114 Powell Bridge Rd.

LOCATION 21 N. (R) on Powell Bridge, at intersection of Powell Bridge and Turkey Foot on (R)

SUBDIVISION n/a BLOCK / SECTION n/a LOT n/a LOT AREA 1 Acre SITE CLASS. RS DESIGN FLOW 360 L.T.A.R. .3

Septic Tank: 1000 Gallons; STB 760 Date 5-14-10
Pump Tank: _____ Gallons; PT _____ Date _____
Pump Make: _____ Model _____ Serial No. _____
Nitrification Field: No Fields 1 Square Feet 1200 Linear Feet 300
No Lines 3 Trench Width 36" Max Trench Bottom Depth 36" Gravel Depth N/A


☒ New System ☐ Repair System Type: I, II, III, IV, V, VI
System Description: 25% Reduction Gravity
Repair System Description: 25% Reduction Gravity
Maintenance Agreement Required: ☐ Yes ☒ No

☒ House/Mod. Home No. Bedrooms 3
☐ Mobile Home No. Bathrooms ____
☐ Business No. Employees ____
☐ Other _____
☐ Slab ☒ Crawl Space ☐ Basement w/plumbing ☐ Basement wo/plumbing

Water Supply:
☒ Individual
☐ Public
☐ Community


Comments:/Conditions:

INITIAL SITE SKETCH

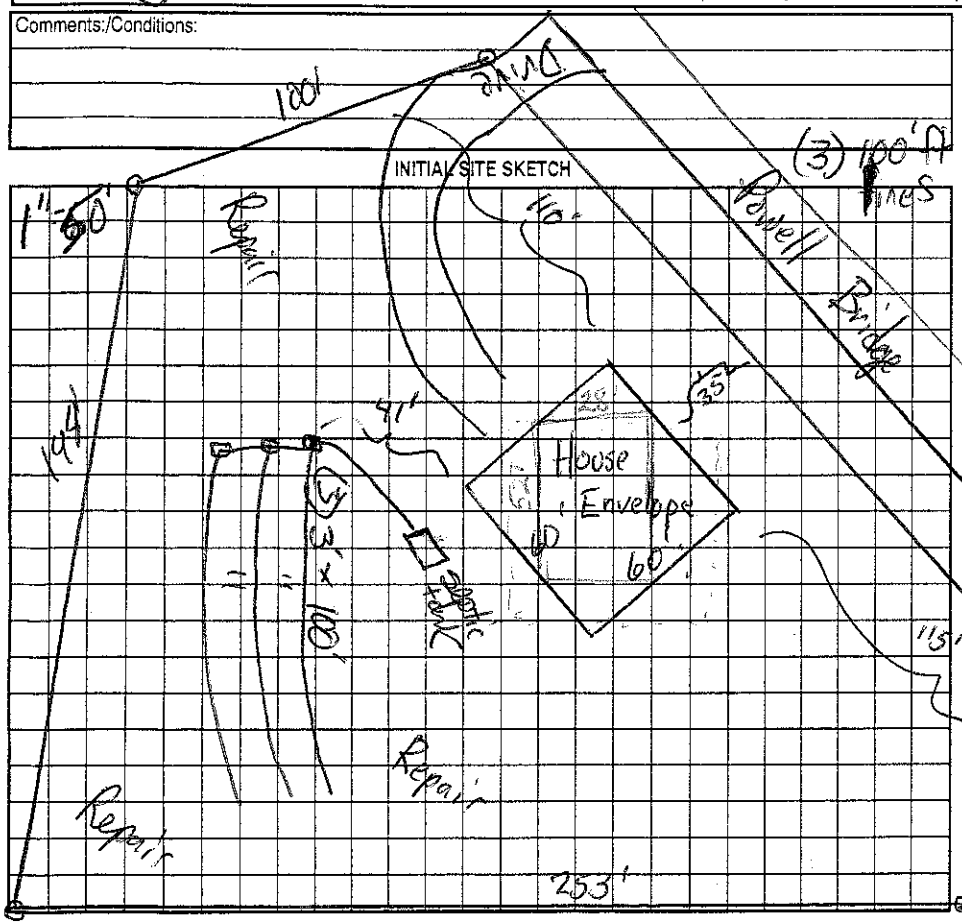

Comments:/Conditions:

AS BUILT SKETCH

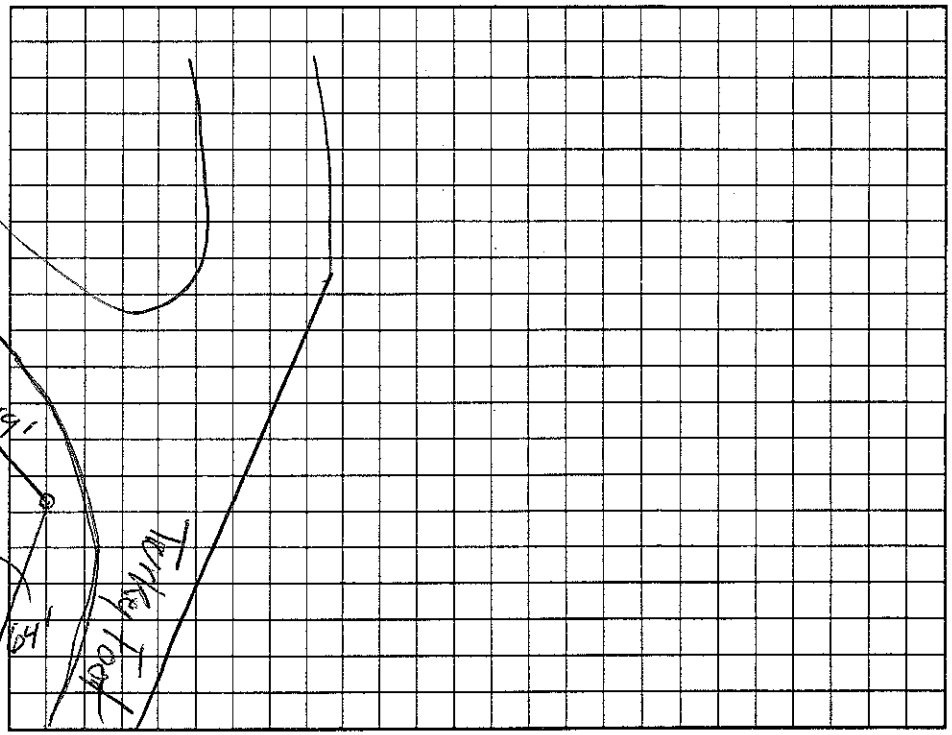

Permit can be suspended or revoked if any false information is supplied toward securing the permit/any unauthorized changes are made to the site/any unauthorized changes are made in the installation of the system. Improvement Permit with plat valid without expiration. Improvement Permit with site plan valid for sixty months. Authorization to Construct is valid for a period equal to that of Improvement Permit – not to exceed sixty months.

Signed: Shannon E. Foland date 7-13-10 Installed by: Brent Gallimore

Improvement Permit by: _____ date 7-9-10 Operation Permit by: _____ date 8-31-10

Authorization to Construct by: _____ date 7-12-10 Existing System Inspection by: _____ date _____

HEALTH DEPT. COPY: WHITE OWNER COPY (FINAL): YELLOW OWNER COPY (INITIAL): PINK