IREDELL COUNTY HEALTH DEPARTMENT

STATESVILLE 704-878-5305 MOORESVILLE 704-664-5281

IMPROVEMENT PERMIT / CERTIFICATE OF COMPLETION / OPERATION PERMIT / EXISTING SYSTEM INSPECTION

PROPERTY DESCRIPTION NO. 069405 DATE 10-9-97 TAX MAP NO. 4892 50 4339

OWNER OR CONTRACTOR LAWRENCE J. ROBINSON PHONE: Business Home 546-5410

ADDRESS 617 ROCK SPRINGS ROAD, HARMONY, NC 28634 Watershed: ☐ Yes ☒ No

LOCATION US 21 N, TR POWELL, TR TURKEY FOOT, TR ROCK SPRINGS, ~ 600 FEET ON RIGHT

SUBDIVISION ROCK SPRINGS BLOCK / SECTION LOT 4 LOT AREA 2.0 ACRES SITE CLASS. PS DESIGN FLOW 360 L.T.A.R. 0.40 GPD/FT²

Septic Tank: 1000 Gallons; STB 783 Date 8-12-98

Pump Tank: Gallons; PT Date

Pump Make: Model Serial No.

Nitrification Field: No Fields 1 Square Feet 900 Linear Feet 300

No Lines FOUR Trench Width 36" Max Trench Bottom Depth 26" Gravel Depth 12"

☒ New System ☐ Repair System Type: I, II, III, IV, V, VI

System Description: CONVENTIONAL GRAVITY

Repair System Description: LPP

Maintenance Agreement Required: ☐ Yes ☒ No

☐ House/Mod. Home ☒ Mobile Home ☐ Business ☐ Other

No. Bedrooms 3 No. Bathrooms 2 No. Employees


☐ Slab ☒ Crawl Space ☐ Basement w/plumbing ☐ Basement wo/plumbing

Water Supply: ☒ Individual ☐ Community ☒ Public WELL


Comments: KEEP SYSTEM MINIMUM 100' FROM WELL

Comments:

INITIAL SITE SKETCH SCALE: 1" = 60'

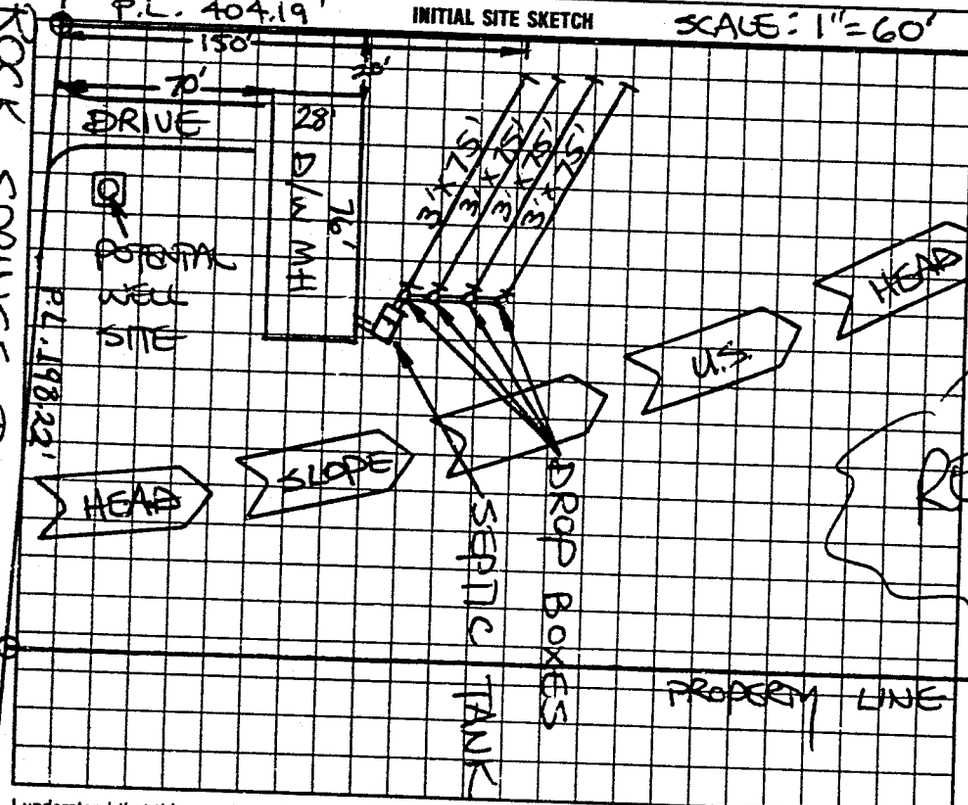

AS BUILT SKETCH

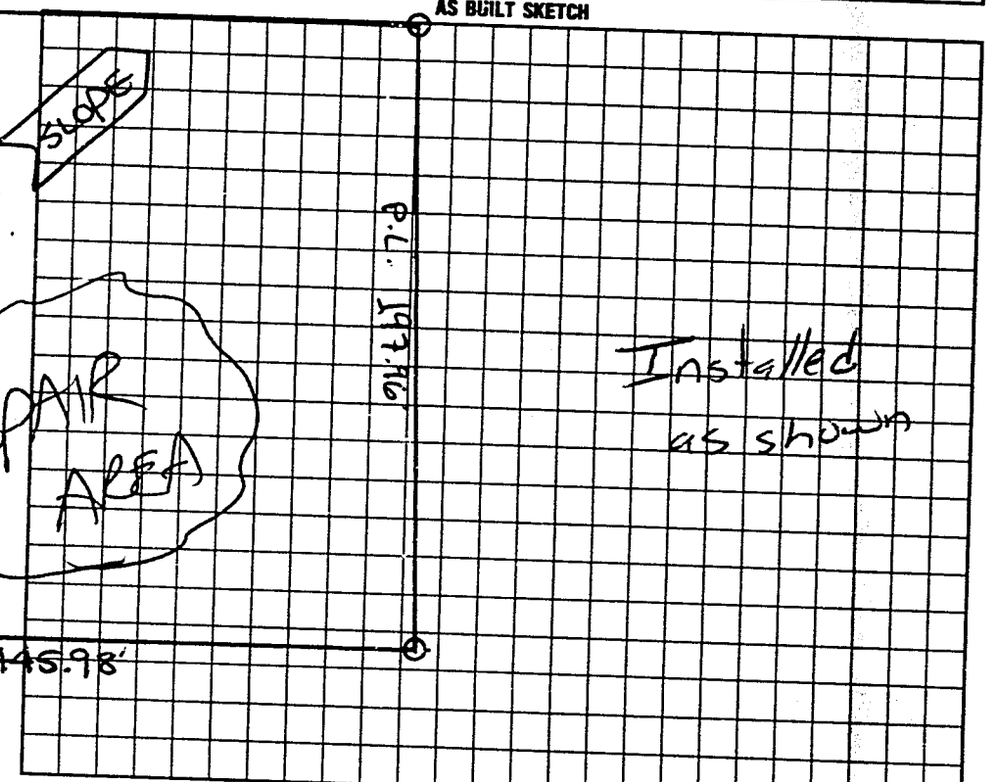

I understand that this permit can be suspended or revoked if any false information is supplied toward securing the permit/any unauthorized changes are made to the site/any unauthorized changes are made in the installation of the system. Improvement Permit is valid for 60 months from date of issuance. AUTHORIZATION TO CONSTRUCT IS VALID FOR 60 MONTHS FROM DATE OF ISSUANCE.

Signed: [signature]

Improvement Permit by: STEVE HEDRICK date 10-9-97

~~Auth. to Const.~~ ~~Existing System Inspection~~ by: STEVE HEDRICK date 10-9-97

Installed by: HB Salmons

~~Certificate of Completion by:~~ date

Operation Permit by: [signature] date 10-16-98

HEALTH DEPT. COPY: WHITE INSPECTION COPY (FINAL): GREEN OWNER COPY (FINAL): YELLOW INSPECTION COPY (INITIAL) PINK OWNER COPY (INITIAL) GOLD