IREDELL COUNTY HEALTH DEPARTMENT

Statesville Phone TR 3-7271 — Mooresville Phone NO 3-1271

PERMIT TO INSTALL SEPTIC TANK

Permit NO. _____ Permit Date Sept 4 19 63

Owner Mr. Milton Dean Store Address Deaton

Installed By Ray T. Lyle Address Statesville


Location of Property On Sheffield Rd. off Lane Valley Rd.

Tank	Capacity	Length of Lines	Fixtures
Block ( )	800 ( )	150' ( )	No. of Baths 2 (½)
Precast ( )	900 ( )	175' ( )	Dishwasher ( )
Poured	1000 (✓)	200' ( )	Garbage Grdr. ( )
	1100 ( )	225' (✓)	Auto-Washer ( )
	1200 ( )	250' ( )	Other _____
	Other _____	Other _____	

NOTIFY HEALTH DEPARTMENT AT LEAST EIGHT HOURS BEFORE TANK IS TO BE INSPECTED.

Final Inspection 10-4 1963 Approved (✓) Disapproved ( )

Remarks Poured

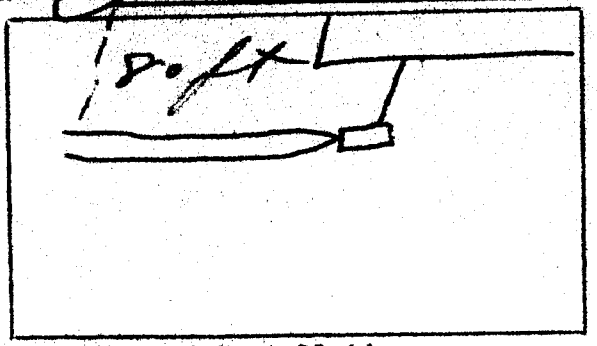

Sketch of Installation

R.A.

Sanitarian