# REDELL COUNTY HEALTH DEPARTMENT

Statesville Office (704) 878-5305 Mooresville Office (704) 660-3625

PERMIT # 205618

PIN # 4892648431

## IMPROVEMENT PERMIT / AUTHORIZATION TO CONSTRUCT / OPERATION PERMIT / EXISTING SYSTEM

APPLICANT: Mark Webber

APPLICANT ADDRESS: 3025 Sandy Springs Rd.

PHONE: 803-295-2276 ALT. PHONE: N/A

SITE ADDRESS: 2080 Sandy Springs Rd.

SITE DIRECTIONS: Hwy 21 N TR Powell Bridge R Turkey Foot JR Sandy Springs Property on Left.

SUBDIVISION: N/A SECTION: N/A LOT # N/A LOT AREA: 6.54 acres DESIGN FLOW: 480gpd L.T.A.R.: 0.275

Septic Tank 1000 (gal) STB 760 Date 6/13/14

Pump Tank (gal) PT Date

Pump Make Model Serial #

# Nitrification Fields 1 # Lines 4 Linear Ft: 436

Trench Width @ 36" Max. Trench Bottom Depth 36" Gravel Depth N/A

☑ New System ☐ Repair ☐ Expansion System Type: I II III IV V VI

System Description: 25% Reduction

Repair System Description: 25% Reduction - Pump

Maintenance Agreement Required: ☐ YES ☑ NO

☑ GRAVITY ☐ PRESSURE

☑ Residence ☐ Business ☐ Other ☐ Slab ☐ Basement w/plumbing


No. Bedrooms 4 No. Persons 3 No. Employees

☐ Crawl Space ☑ Basement w/o plumbing

Water Supply: ☑ Private ☐ Public ☐ Community

Comments / Conditions: IMPROVEMENTS ONLY! Submit floor plan prior to issuance of CA! Install a 25% Reduction system on contour with serial distribution. Well Area is +100' from all components of septic tank system.

INITIAL SITE SKETCH

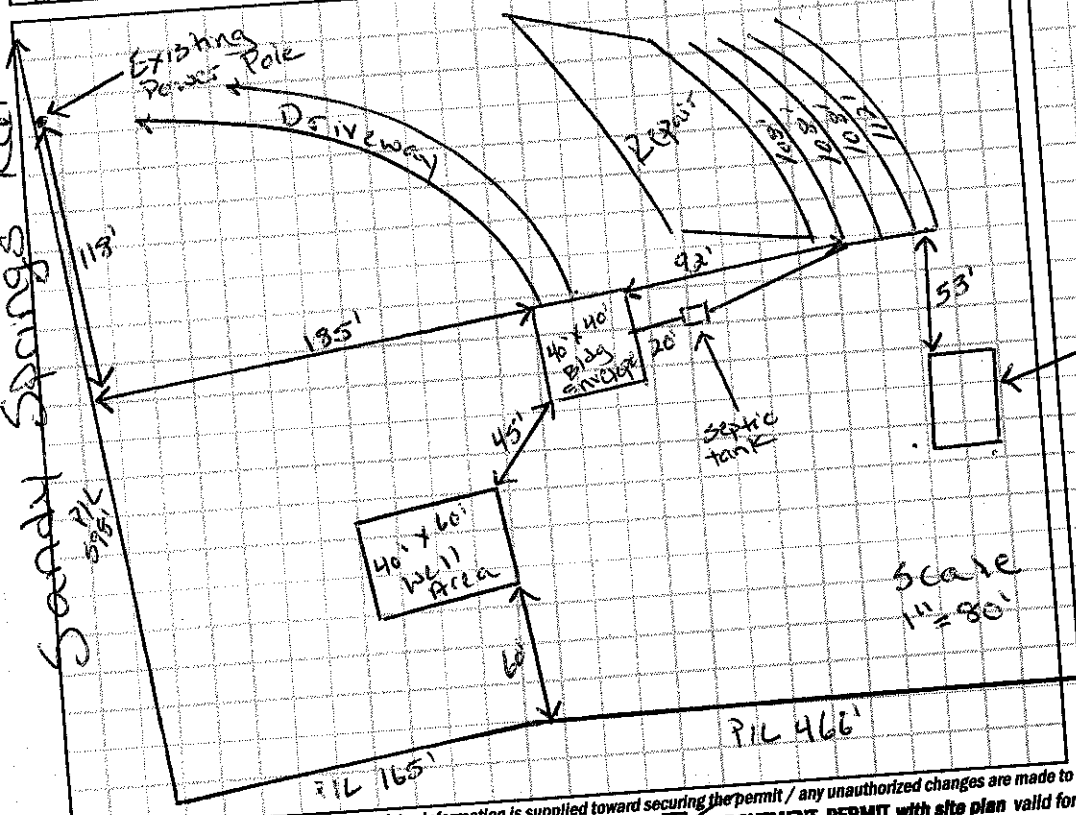


AS BUILT SKETCH

red polylok filter chambers quick 4 installed as drawn

Permit can be suspended or revoked if any false information is supplied toward securing the permit / any unauthorized changes are made to the site / any unauthorized changes are made in the installation of the system. CONTACT A LOCATOR SERVICE PRIOR TO ANY EXCAVATION

☐ IMPROVEMENT PERMIT with plat valid without expiration.

☑ IMPROVEMENT PERMIT with site plan valid for 60 mos.

☐ AUTHORIZATION TO CONSTRUCT valid for period equal to IMPROVEMENT PERMIT--not to exceed 60 mo.

Owner / Applicant Signature: [signature] Date: 9-22-14

IMPROVEMENT PERMIT by: Justin Henderson Date: 9-19-14

Installed by: Jeaffrey Bradley Date: 12/1/14

OPERATION PERMIT by: Richard Tubbs Date: 9/25/14

Existing System Inspected by:

White - Approval - YELLOW Applicant (Conditional Approval) - PINK