THIS PERMIT VOIDS PREVIOUS ISSUED 10-14-96

IREDELL COUNTY HEALTH DEPARTMENT

STATESVILLE 704-878-5305 MOORESVILLE 704-664-5281

IMPROVEMENT PERMIT / AUTHORIZATION TO CONSTRUCT / OPERATION PERMIT / EXISTING SYSTEM INSPECTION

PERMIT# 103605 PIN# 4892-65-3901 DATE 12-7-01

OWNER OR CONTRACTOR CHARLES MABRY PHONE: Business Home (336) 767-6341

ADDRESS 3021 N. CLEVELAND AVE, WINSTON-SALEM, NC 27105

LOCATION US 21N, TR E. HOUSTONVILLE RD, TR SANDY SPRINGS RD, TL JOYNER ROAD, ~0.3 MILE ON LEFT

SUBDIVISION _____ BLOCK / SECTION _____ LOT _____ LOT AREA 23 ACRES SITE CLASS PS DESIGN FLOW 360 L.T.A.R. 0.30 GPD/FT²

Septic Tank: 1000 Gallons: STB 780 Date 10-6-01
Pump Tank: _____ Gallons: PT _____ Date _____
Pump Make: _____ Model _____ Serial No. _____
Nitrification Field: No Fields 1 Square Feet 1200 Linear Feet 400
No Lines THREE Trench Width 36" Max Trench Bottom Depth 30"

☑ New System ☐ Repair System Type: I (II) III, IV, V, VI
System Description: CONVENTIONAL GRAVITY
Repair System Description: 25% REDUCTION, GRAVITY
Maintenance Agreement Required: ☐ Yes ☑ No
Gravel Depth 12" ☐ Slab ☐ Crawl Space ☐ Basement w/plumbing ☑ Basement wo/plumbing


☑ House/Mod. Home No. Bedrooms 3
☐ Mobile Home No. Bathrooms 2
☐ Business No. Employees _____
☐ Other _____

Water Supply: ☑ Individual ☐ Public ☐ Community
WELL


Comments/Conditions: ① KEEP SYSTEM MINIMUM 15 FEET FROM BASEMENT, 100 FEET FROM WELL
② INSTALL LINES NO DEEPER THAN 30"

Comments/Conditions:
- Zabel Filter Installed
- Septic Tank Marker Installed

INITIAL SITE SKETCH

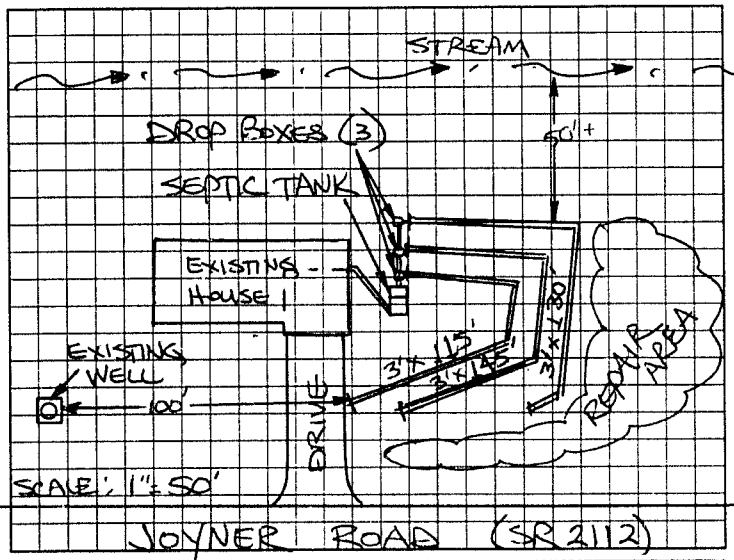

AS BUILT SKETCH

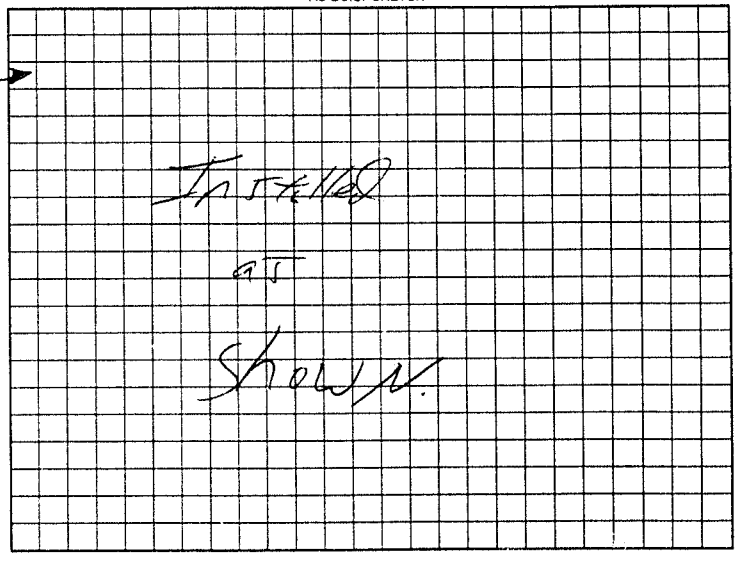

Permit can be suspended or revoked if any false information is supplied toward securing the permit/any unauthorized changes are made to the site/any unauthorized changes are made in the installation of the system. Improvement Permit with plat valid without expiration. Improvement Permit with site plan valid for sixty months. Authorization to Construct is valid for a period equal to that of Improvement Permit – not to exceed sixty months.

Signed: Charles Mabry date 12/11/01 Installed by: Sherman Dunn

Improvement Permit by: STEVE HEDRICK date 12-7-01 Operation Permit by: William G. Johnson date 12/20/01

Authorization to Construct by: STEVE HEDRICK date 12-7-01 Existing System Inspection by: _____ date _____

HEALTH DEPT COPY WHITE OWNER COPY (FINAL) YELLOW OWNER COPY (INITIAL) PINK