IREDELL COUNTY HEALTH DEPARTMENT

Statesville Office (704) 878-5305 Mooresville Office (704) 660-3625 PERMIT # 217031

IMPROVEMENT PERMIT / AUTHORIZATION TO CONSTRUCT / OPERATION PERMIT / EXISTING SYSTEM

PIN # 4892755245

APPLICANT: Margaret Pendergrass APPLICANT ADDRESS: 134 Joyner Rd Mocksville NC

SITE ADDRESS: 134 Joyner Rd Mocksville NC PHONE: 704-546-7607 ALT. PHONE: 704-546-2272

SITE DIRECTIONS: 21N T/L Powell Bridge Rd T/L Turkey Foot T/L Sandy Springs T/L Joyner Lot on right


SUBDIVISION: N/A SECTION: N/A LOT # N/A LOT AREA: 1.484ac DESIGN FLOW: 360 L.T.A.R.: 0.3

Septic Tank	Ex (gal)	STB	Date	☐ New System ☒ Repair ☐ Expansion System Type: I II III IV V VI	☐ Residence	No. Bedrooms 3	Water Supply
Pump Tank	(gal)	PT	Date	System Description: 25% Reduction	☐ Business	No. Persons 6	☒ Private
Pump Make	Model		Serial #	Repair System Description:	☐ Other	No. Employees	☐ Public
# Nitrification Fields 1	# Lines 3		Linear Ft: 298	Maintenance Agreement Required: ☐ YES ☒ NO	☐ Slab	☐ Crawl Space	☐ Community
Trench Width 36"	Max. Trench Bottom Depth 36"		Gravel Depth N/A	☒ GRAVITY ☐ PRESSURE	☒ Basement w/plumbing		☐ Basement w/o plumbing


Comments / Conditions: Install 25% reduction on contour with Serial distribution. Earthen Dam existing lines when encountered. Check tank check tee replace if needed.

* maintain 36" TD on high side *

INITIAL SITE SKETCH

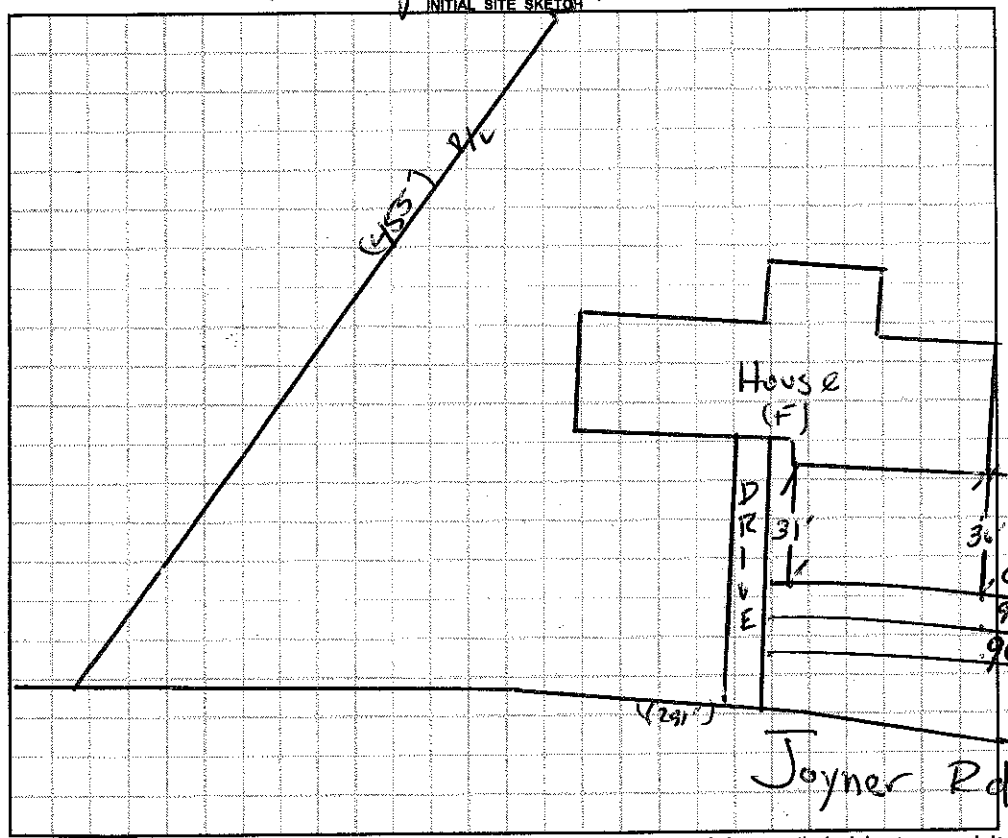

AS BUILT SKETCH 1"=50

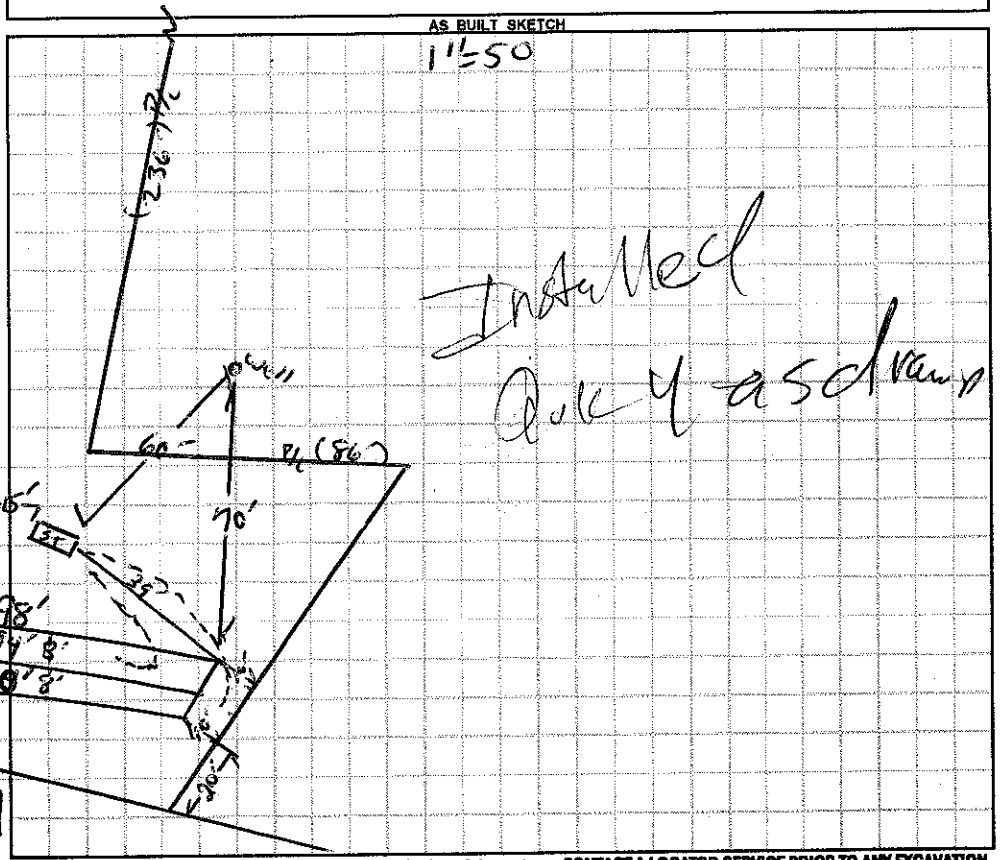

Permit can be suspended or revoked if any false information is supplied toward securing the permit / any unauthorized changes are made to the site / any unauthorized changes are made in the installation of the system. **CONTACT A LOCATOR SERVICE PRIOR TO ANY EXCAVATION**

☐ **IMPROVEMENT PERMIT** *with plat valid without expiration.* ☒ **IMPROVEMENT PERMIT** *with site plan valid for 60 mos.* ☒ **AUTHORIZATION TO CONSTRUCT** *valid for period equal to IMPROVEMENT PERMIT--not to exceed 60 mo.*

Owner / Applicant Signature: Margaret Pendergrass Date: 3-10-16 Installed by: Tommy Bruce

IMPROVEMENT PERMIT by: Date: 03/10/16 OPERATION PERMIT by: Date: 03/24/16

AUTHORIZATION TO CONSTRUCT by: Date: 03/10/16 Existing System Inspected by: Date:

Health Dept. Copy - WHITE Applicant (Final Approval) - YELLOW Applicant (Conditional Approval) - PINK