IREDELL COUNTY HEALTH DEPARTMENT

STATESVILLE 704-878-5305 MOORESVILLE 704-664-5281

IMPROVEMENT PERMIT / CERTIFICATE OF COMPLETION / OPERATION PERMIT / EXISTING SYSTEM INSPECTION

PROPERTY DESCRIPTION NO. 070192 DATE 10-30-97 TAX MAP NO. 4892 16 2514 Watershed: ☐ Yes ☒ No

OWNER OR CONTRACTOR WANDA K. BENTON PHONE: Business Home 546-2999

ADDRESS 210 JOYNER ROAD MOCKSVILLE NC 27028

LOCATION US 21 N, TR POWELL BRIDGE, TL TURKEYFOOT TR, SANDY SPRINGS, TL JOYNER, ON (R) AFTER CREEK BRIDGE

SUBDIVISION BLOCK / SECTION LOT LOT AREA 2.0 ACRES (PT) SITE CLASS. PS DESIGN FLOW 360 L.T.A.R. 0.35 GPD/FT²

Septic Tank: 1000 Gallons; STB 6020 Date 9-8-98

Pump Tank: Gallons; PT Date

Pump Make: Model Serial No.

Nitrification Field: No Fields 1 Square Feet 1055 Linear Feet 345

No Lines THREE Trench Width 36" Max Trench Bottom Depth 36" Gravel Depth 12"

☒ New System ☐ Repair System Type: I, II, III, IV, V, VI

System Description: CONVENTIONAL GRAVITY

Repair System Description: CONV. GRAVITY

Maintenance Agreement Required: ☐ Yes ☒ No

☐ House/Mod. Home ☒ Mobile Home ☐ Business ☐ Other PLANNED FOR 3BR

No. Bedrooms 2 No. Bathrooms 1 No. Employees

☐ Slab ☒ Crawl Space ☐ Basement w/plumbing ☐ Basement wo/plumbing


Water Supply: ☒ Individual ☐ Community ☐ Public WELL

Comments:


Comments: SYSTEM INSTALLED ACCORDING TO INITAL SITE SKETCH

BEHIND MH AT BOX #210

INITIAL SITE SKETCH SCALE: 1"=50'

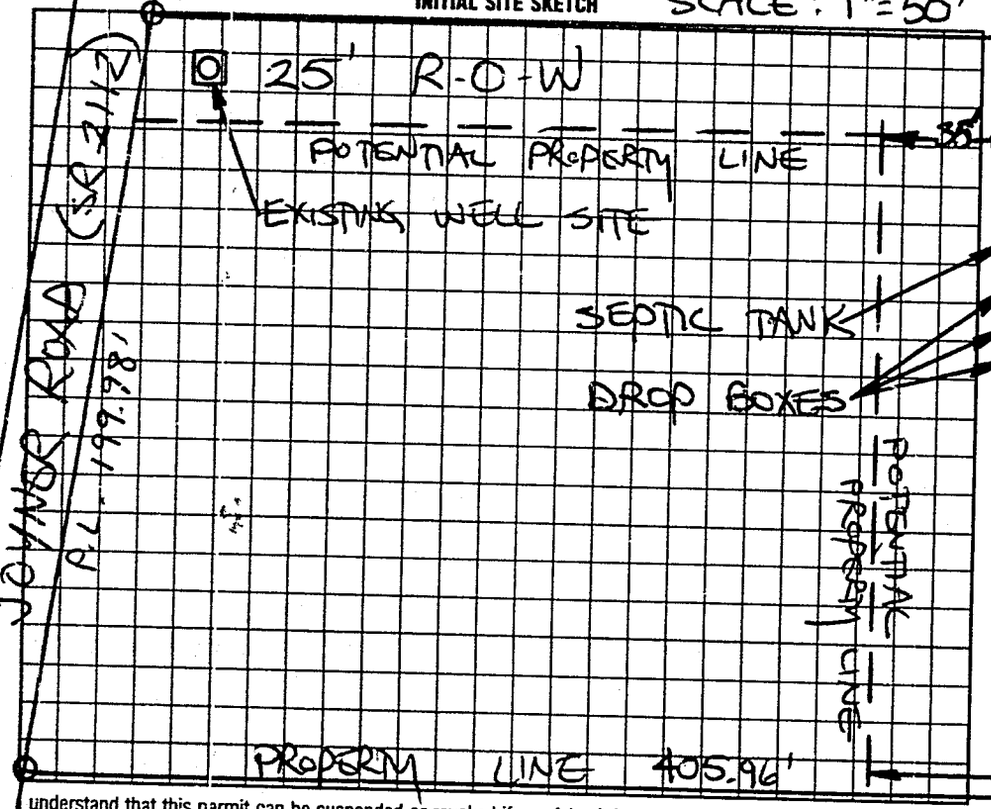

AS BUILT SKETCH

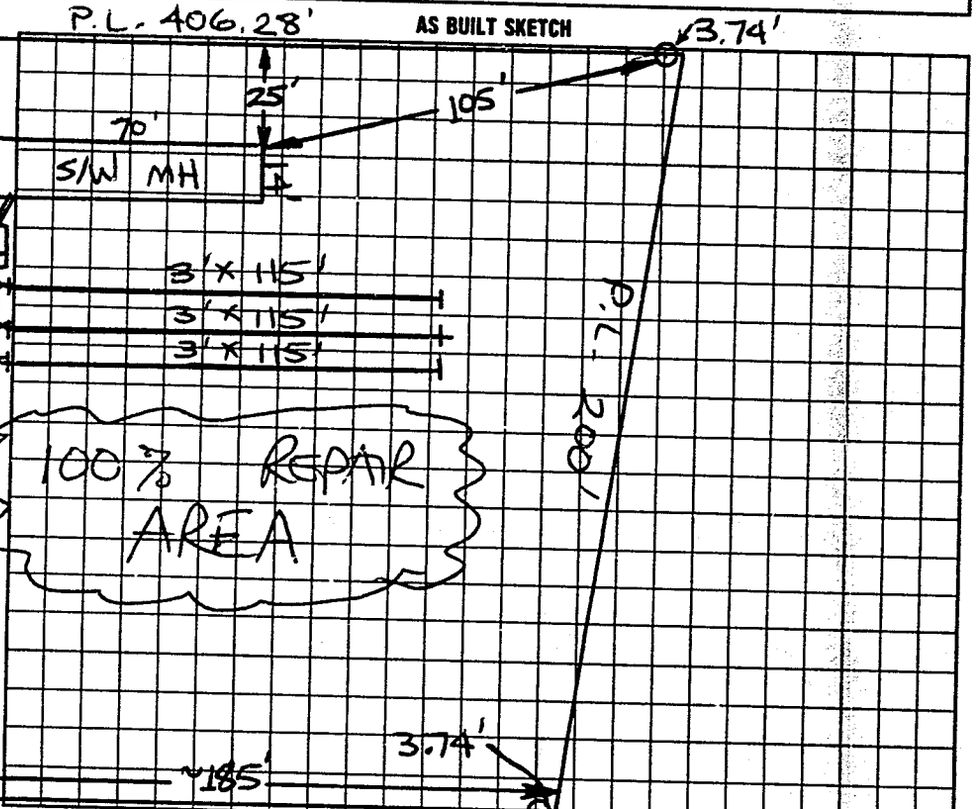

I understand that this permit can be suspended or revoked if any false information is supplied toward securing the permit/any unauthorized changes are made to the site/any unauthorized changes are made in the installation of the system. Improvement Permit is valid for 60 months from date of issuance. AUTHORIZATION TO CONSTRUCT IS VALID FOR 60 MONTHS FROM DATE OF ISSUANCE.

Signed: Wanda Benton

Improvement Permit by: STEVE HEDRICK date 10-30-97

AUTH. TO CONST.

Existing System Inspection by: STEVE HEDRICK date 10-30-97

Installed by: SAMMY REAVIS

~~Certificate of Completion by:~~ date

Operation Permit by: STEVE HEDRICK date 11-9-98

HEALTH DEPT. COPY: WHITE INSPECTION COPY (FINAL): GREEN OWNER COPY (FINAL): YELLOW INSPECTION COPY (INITIAL): PINK OWNER COPY (INITIAL): GOLD